


Section 31 Township 22 Range 10 E

Well No. # 1 Underwood

Company Miller & Snyder

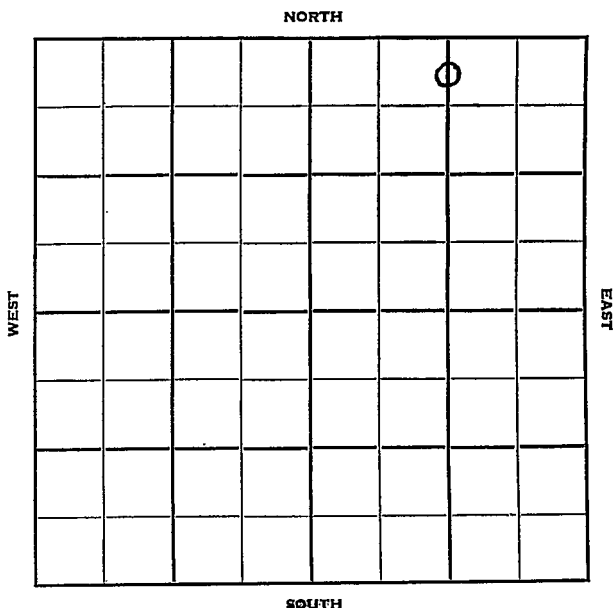

Sec. 31 Twp. 22 R. 10E

Well No. #1 Underwood Farm

Miller & Snyder Company

Browning Contractor


330' Ft. from N. Line

_____ Ft. from S. Line

1320' Ft. from E. Line

_____ Ft. from W. Line

C N/2 N/2 NE

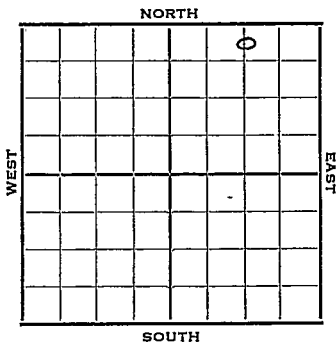

1952

Elev. -

REPORT

3/12

MIR

4/16

Spud 3-14-52

Oil Well TD 2512

8" @ 72

Bart 2426 TD 2431 5" @ 2426

DD 2512 PB 2453 Stratolift

3 bfph FU 800' oil 200' wtr. 18 hr.

Comp. 4 bopd

COMPLETED

County **Greenwood** State **Kansas**

Sec. **31** (Blk. Twp.) **22** (Sur. Rge.) **10E** Map No.

Operator **Miller & Snyder**

Well No. **1** Farm **Underwood**

Elev. Location **C N/2 N/2 NE**

FIRST REPORT

330 Ft. From **N** Line **NE**

1320 Ft. From **E** Line Quarter

Ist. Report **MAR 12 1952**

Completion

Remarks

Spudding Date

Drig. Data **Browning**

MIR

J. G. McGEHEE

County **Greenwood** State **Kansas**

Sec. **31** (Blk. Twp.) **22** (Sur. Rge.) **10E** Map No.

Operator **Miller & Snyder**

Well No. **1** Farm **Underwood**

Elev. Location **C N L N $\frac{1}{2}$ NE**

330 Ft. From **N** Line **NE**

1320 Ft. From **E** Line **Quarter**

1st. Report

Completion **APR 16 1952**

Remarks **Browning Pool**

COMPLETE

Spudding Date **3-14-52**

Drlg. Data **Oil well TD 2512**

8" @ 72 Bart. 2426 TD 2431 5" @ 2426

DD 2512 PB 2453 stratolift 3 bfph

FU 800' oil 200' water 18 hr.

Comp. 4 bopd