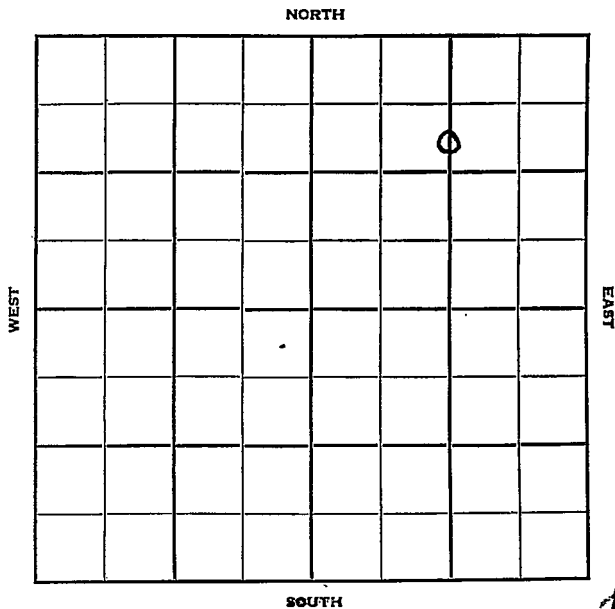


Section 31 Township 22 Range 10 ^EWell No. # 2 UnderwoodCompany Miller & Snyder

Greenwood

KANSAS

Sec. 31 Twp. 22 R. 10E

Well No. #2 Underwood Farm

Miller & Snyder Company

Contractor


990' Ft. from N. Line

_____ Ft. from S. Line

1320' Ft. from E. Line

_____ Ft. from W. Line

C S/2 N/2 NE

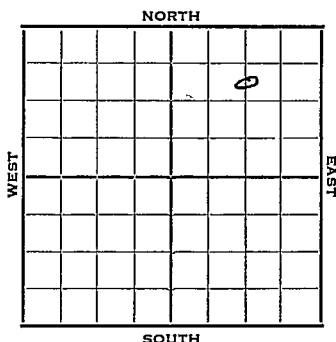

1952

Elev. -

R E P O R T

4/9
4/16

RUR

Spud 4-3-52

D&A TD 2541

8" @ 130'

Bart 2456 TD 2541'

D&A

ABANDONED

County Greenwood State Kansas
 Sec. 31 (Blk.) 22 (Sur.) 10E Map No.

Operator Miller & Snyder

Well No. 2 Farm Underwood

Elev. _____ Location C S/2 N/2 NE

FIRST REPORT

990 Ft. From N Line NE

1320 Ft. From E Line Quarter

1st. Report APR 9 1952

Completion _____

Remarks _____


Spudding Date _____

Drlg. Data _____

RUR

J. G. MCGEHEE

County Greenwood State Kansas
 Sec. 31 (Bk.
Twp.) 22 (Sur.
Rge.) 10E Map No.
 Operator Miller & Snyder
 Well No. 2 Farm Underwood
 Elev. Location C SL N $\frac{1}{2}$ NE

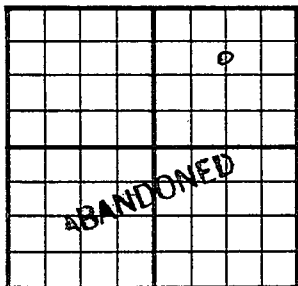

990 Ft. From N Line NE
1320 Ft. From E Line Quarter
 1st. Report
 Completion APR 1 6 1952
 Remarks
 Spudding Date 4-3-52

Drilg. Data D & A TD 2541
8" @ 130 Bart. 2456 TD 2541
D & A

J. G. McGEHEE