

Sec. 31 Twp. 22 R. 11E

Well No. #4 Galbraith Farm

Lance Hill Company

White & Ellis Contractor


Ft. from N. Line

1768 Ft. from S. Line

126 Ft. from E. Line

Ft. from W. Line

SE NE SE

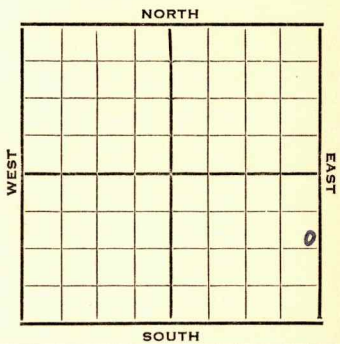

1953 Elev. - REPORT

2/18 Spud 2-14-53
8" @ 85
Drlg. 1200'

3/18 Spud 2-14-53 Oil well TD 2000
8" @ 85 Lans. 1028 KC 1305
Bart 1976 TD 1978 5" @ 1973
DD 2000' 47 qt/ FU 500' fluid
Compl. 11 BOPD 15 BW

COMPLETED

