


DX 78-1 Greenwood

KANSAS ✓

Section 31 Township 22 Range 11E

Well No. #5 Galbraith

Company Lance Hill

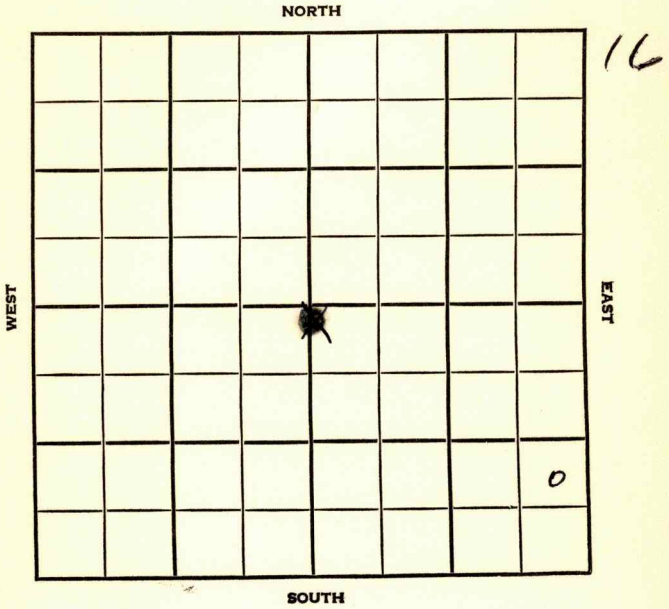

Greenwood KANSAS

SEC.	TWP.	R.
31	22	11E

WELL NO. **5 Galbraith** FARM

COMPANY **Lance Hill**


CONTRACTOR **White & Ellis**

Seely-Wick Pool

_____ Ft. from N. Line
1025 _____ Ft. from S. Line

360 _____ Ft. from E. Line

_____ Ft. from W. Line

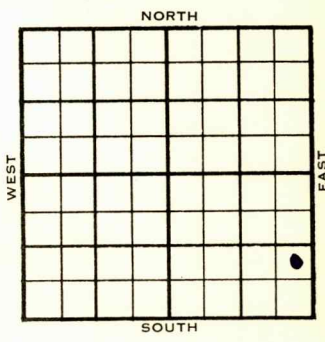

NE SE SE

	ELEVATION	REPORT
1954	-	
11/3		Spud 10-27-54 8" @ 100' Bart 1965' TD 1987' 5" @ 1969'
12/1		Spud 10-27-54 Oil Well TD 1997' 8" @ 100' Bart. 1965' TD 1987' 5" @ 1969' DD 1997' PB 1995 frac. Comp 15 bopd 25 % Wtr.

COMPLETED

