

Map No. KANSAS Sec. 32 Twp. 22 R. 1E

Well No. 1- Sheridan Farm
J.P. Flanagan Company
NORTH


_____ Ft. from N. Line

1320 Ft. from S. Line

_____ Ft. from E. Line

1320 Ft. from W. Line

193 1/2 SW 1/4 & W 1/2 - SE 1/4 of Sec 31-22-1E
OUR lease -

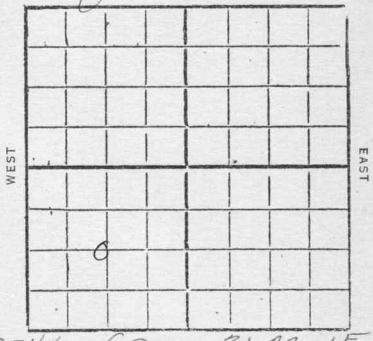

Date	REPORT
6/24	Bldg rig
7/11	Key
7/8	Spdg. 250'
7/15	Key 990'
7/22	" 1640'
7/29	8 bailer water at 1830
	Wreg 2050'
8/5	10"- 2130'
8/12	HFV 2445
	Dreg 2455
8/19	8"- 2560
	Dreg 2630'
8/26	HFV 2665
	TD. 2780' UIR 8"
9/2	Top chat 2951
	4 bailer water
	TD. 2960 UIR 8"
9/9	TD. 2977' UIR 8"
9/16	8"- 2988
	9 bailer water 2993
	HFV 3045
	Dreg 3105'

9/23- Base lime 3274
T.D. 3280' fsg tools

9/30- HFW 3400
drlg 3440 sdy lime

10/7- 6"-3484
Failed to shut off
drlg 3522 lime

10/14- Top Wilcox 3530
Top Silc lime 3606
T.D. 3610
Well run 5"

10/21- Drlg 3653

10/28- " 3760'

11/4- " 3870'

11/10- " 3948

11/18- " 3990'

11/24- " 4092

12/2- T.D. 4120

Dry & abandon

KANSAS

Harvey
32 Twp. 22 R. 1 E

Map No. _____ Sec. _____ Twp. _____ R. _____

Well No. 1 Sheridan _____

J. P. Flanagan _____ Company

_____ Contractor

FIRST REPORTS

_____ Ft. from N. Line

1320 Ft. from S. Line

_____ Ft. from E. Line

1320 Ft. from W. Line

SECTION PLAT

Location _____

Rig up _____

Drilling and Remarks:

Blow Rig

RECORD

Cased _____ in., _____ ft.

Sand _____

Gas _____

Oil _____

Total Depth _____

PRODUCTION

1st 24 hrs. Nat. _____

1st 24 hrs. after shot _____

Gas _____ Cu. Ft.

Dry Hole _____

Abandoned _____

Date JUN 24 1931

CHAS. L. SHERWOOD

192 _____ Scout

Company
Contractor

SECTION PLAT

Handwritten scribbles and lines, possibly initials or signatures, extending across the page.

Returned.....	<i>JB</i>
Cards.....	<i>JB</i>
Tracing.....	<i>JB</i>
France Map.....	<i>JB</i>
Scarborough M.....	<i>JB</i>
Moody Map.....	<i>JB</i>
Scarborough Plat Book.....	<i>JB</i>
Moody Plat Book.....	<i>JB</i>

24 **KANSAS** Sec. 32 Twp. 22 R. 1 E

Well No. 1 Sheridan

J.P. Flanagan Company

Contractor

COMPLETED


.....Ft. from N. Line

1320 Ft. from S. Line

.....Ft. from E. Line

1320 Ft. from W. Line

SECTION PLAT

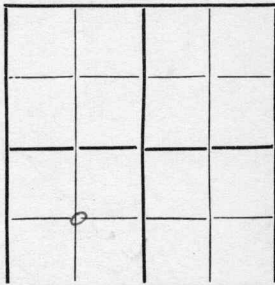

ABANDONED

Location.....

Rig up.....

Drilling and Remarks:

RECORD

Cased.....in.,ft.

Sand.....

Gas.....

Oil.....

Total Depth 4120

PRODUCTION

1st 24 hrs. Nat.....

1st 24 hrs. after shot.....

Gas.....Cu. Ft.

Dry Hole..... ✓

Abandoned..... ✓

Date

DEC

2 1931

CHAS. L. SHERWOOD

.....192.....

.....Scout



Returned	
Cards	
Tracing	<i>CPK</i>
France Map	<i>X</i>
Scarborough Map	<i>X</i>
Moody Map	<i>X</i>
Scarborough Plat Book	<i>X</i>
Moody Plat Book	<i>X</i>

Date