
FORM 51-5M-6-29-PETROL

Greenwood

Map No. KANSAS Sec. 32 Twp. 22 R. 42E

Well No. 1 Steele Farm

J. K. Simmons Company

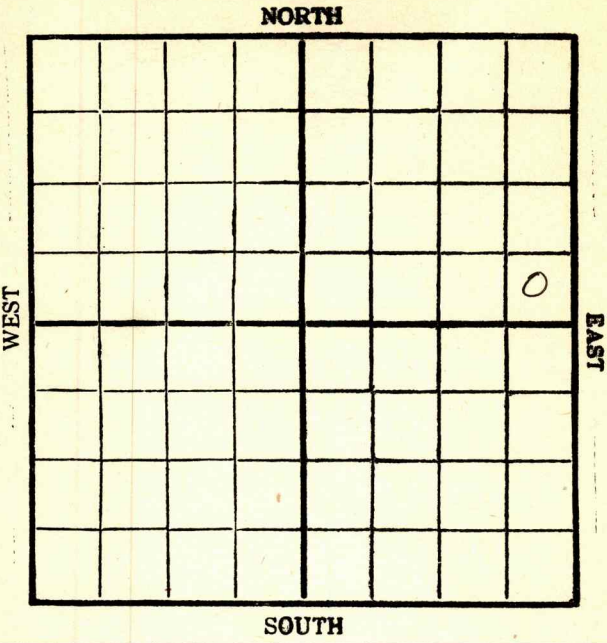

Location

Drilling Remarks

Rig Up

Drilling Remarks

RECORD

Cased ____ in. ____ ft.

Sand

Gas

Oil

Total Depth

PRODUCTION

1st 24 hrs. Nat.

1st 24 hrs. after shot

Gas ____ cu. ft.

Dry Hole

Abandoned


Greenwood

Form 252A—5M—10-26—24951

Map No. KANSAS Sec. 32 Twp. 22 R. 12E

Well No. 1 Steele Farm

J. K. Simmons Company

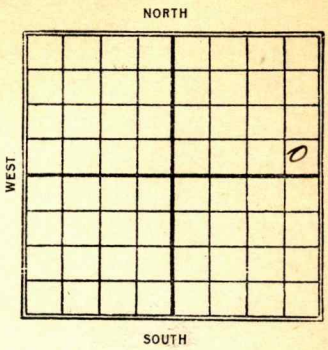

____ Ft. from N. Line

330 Ft. from S. Line

330 Ft. from E. Line

____ Ft. from W. Line

1929

Date	REPORT
8/28	Location
9/4	—
9/11	—
9/18	—
9/25	—
10/2	Rigg up
10/9	"
10/16	Rigd up & SD.
10/23	Drlg 1600'
10/30	" 1665'
11/6	No sand Top Lime 1845' 2 bailer water T.D. 1940' 5 bailers water Abandoned

Form 26—1M Bks. 9-28

Sherwood

Map No. KANSAS Sec. 32 Twp. 22 R. 12

Well No. 21 Steele

T. L. Simmons Company

Contractor

COMPLETE

330 Ft. from N. Line


330 Ft. from S. Line

330 Ft. from E. Line

Ft. from W. Line

ABANDONED

SECTION PLAT

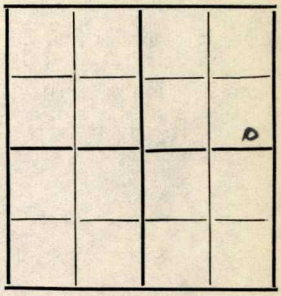

Location

Rig up

Drilling and Remarks:

No Sand

Top Lime 1845

7 BW.

RECORD

Cased in., ft.

Sand

Gas

Oil

Total Depth 1940 5 BW.

PRODUCTION

1st 24 hrs. Nat.

1st 24 hrs. after shot

Gas Cu. Ft.

Dry Hole ✓

Abandoned ✓

Date

NOV 6 1929

192

CHAS. L. SHERWOOD

Scout

Form 26—1M Bks.—2-29

Greenwood

KANSAS

Map No. 21 Sec. 32 Twp. 22 R. 12 E

Well No. 1 Steele

T. B. Simmons Company

Contractor

FIRST REPORTS


Ft. from N. Line

330 Ft. from S. Line

330 Ft. from E. Line

Ft. from W. Line

SECTION PLAT

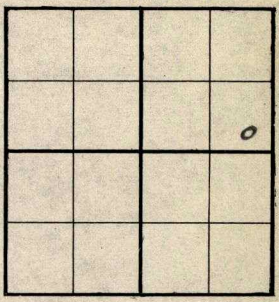

Location ✓

Rig up

Drilling and Remarks:

RECORD

Cased in., ft.

Sand

Gas

Oil

Total Depth

PRODUCTION

1st 24 hrs. Nat.

1st 24 hrs. after shot

Gas Cu. Ft.

Dry Hole

Abandoned

Date

AUG 28 1929

19

CHAS. L. SHERWOOD

Scout