


Map No. Greenwood ✓
 Sec. 32 Twp. 22 R. 11
 Well No. 1-Cragan Farm
Connell Oil Company

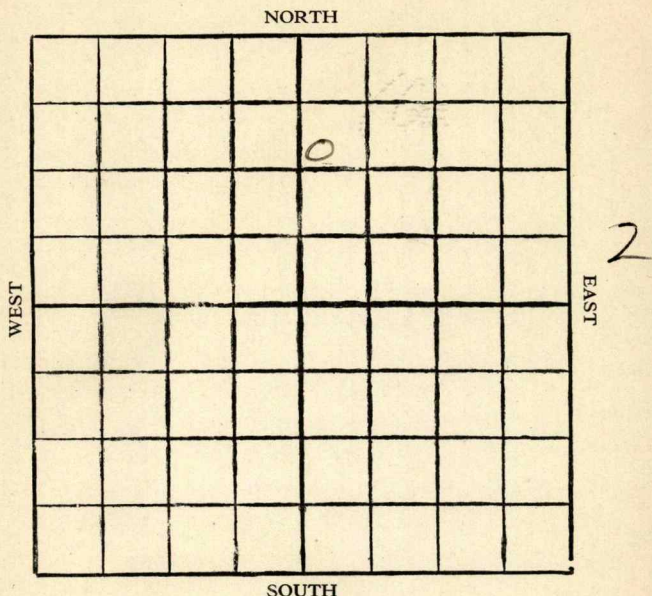

Location

Drilling Remarks

Rig Up

Drilling Remarks

RECORD

Cased.....in.ft.

Sand

Gas

Oil

Total Depth.....

PRODUCTION

1st 24 hrs. Nat.....

1st 24 hrs. after shot.....

Gas.....cu. ft.


Dry Hole.....

Abandoned

Map No. K Sec. 32 Twp. 22 R. 11Well No. 1-Cragon Farm
Connell oil Company1270 Ft. from N. Line

_____ Ft. from S. Line

_____ Ft. from E. Line

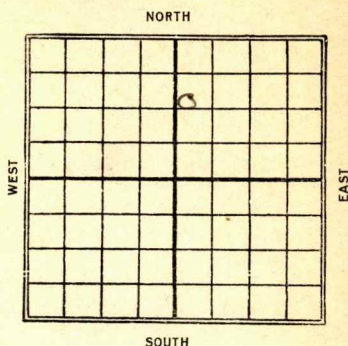50 Ft. from W. Line1927

Date

REPORT

<u>4/20</u>	<u>Loc.</u>
<u>4/27</u>	<u>Timbers</u>
<u>5/5</u>	<u>Rig</u>
<u>5/12</u>	_____
<u>5/18</u>	<u>Spudded + S.D.</u>
<u>5/25</u>	_____
<u>6/1</u>	_____
<u>6/7</u>	_____
<u>6/15</u>	_____
<u>6/22</u>	_____
<u>6/29</u>	_____
<u>7/7</u>	_____
<u>7/13</u>	_____
<u>7/20</u>	_____
<u>7/28</u>	_____
<u>8/4</u>	_____
<u>8/10</u>	_____
<u>8/18</u>	_____
<u>8/24</u>	_____
<u>9/1</u>	_____
<u>9/7</u>	_____
<u>9/14</u>	_____

9/29 - Dry 640 -

10/6 - " 900

10/12 - " 1050

10/19 - sand 1939-1972

Good show oil

100/did not help

N. & A. 2050

21 **KANSAS** 32 Twp. 22 R. 11
 Map No. _____ Sec. _____ Twp. _____ R. _____

Well No. _____
Connell Oil Co _____ Company

 Contractor

COMPLETED

SECTION PLAT

1770 _____ Ft. from N. Line

_____ Ft. from S. Line

_____ Ft. from E. Line

50 _____ Ft. from W. Line

ABANDONED

Location _____

Rig up _____

Drilling and Remarks:

Sept 1929-1972
Good show oil.
100' dip not kept.
dry & ab'd
28 2050

RECORD

Cased _____ in., _____ ft.

Sand _____

Gas _____

Oil _____

Total Depth *2050* _____

PRODUCTION

1st 24 hrs. Nat. _____

1st 24 hrs. after shot _____

Gas _____ Cu. Ft.

Dry Hole ☒ _____

Abandoned ☒ _____

Date

OCT 19 1927

CHAS. L. SHERWOOD

192

Scout

Sherwood

21 **KANSAS** Sec. 32 Twp. 22 R. 11

Well No. 1 *Cragon*
Cornell Oil Co Company

Contractor

FIRST REPORTS

SECTION PLAT

1270 Ft. from N. Line
 _____ Ft. from S. Line
 _____ Ft. from E. Line
 50 Ft. from W. Line

Location ✓ _____

Rig up _____

Drilling and Remarks:

*This well is a
 twin to #4 well
 which was drilled
 by Empire.*

RECORD

Cased _____ in., _____ ft.
 Sand _____
 Gas _____
 Oil _____
 Total Depth _____

PRODUCTION

1st 24 hrs. Nat. _____
 1st 24 hrs. after shot _____
 Gas _____ Cu. Ft.
 Dry Hole _____
 Abandoned _____

Date

APR 20 1927

CHAS. L. SHERWOOD

192

Scout