


SECTION 32 TOWNSHIP 22 RANGE 11E

WELL NO. #1 Cragen

COMPANY John Riley (Eureka)

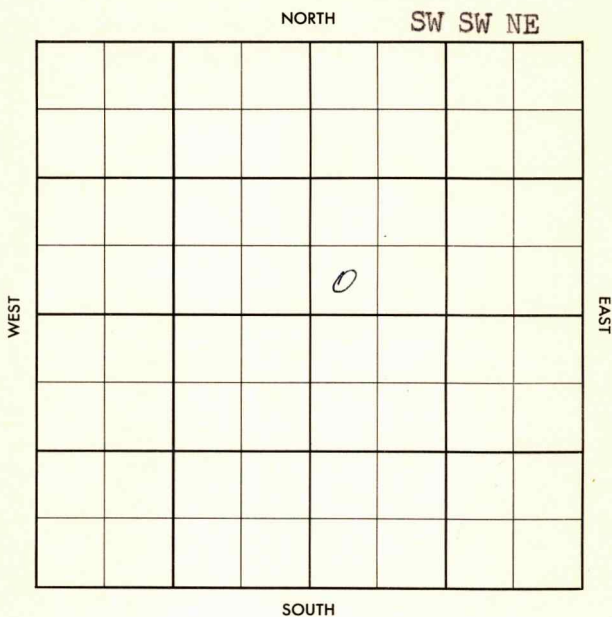

County Greenwood Elev. _____
 Sec. 32 Twp. 22 Rgs. 11E
 Company John Riley (Eureka)
 Farm Name Cragen No. 1

TOPS	DEPTH	LOG	DATUM	Loc. in Sec.						
Anh.				SW SW NE						
Tr.				450' fcl-450'						
Dg.				fsl NE $\frac{1}{4}$						
Bl. <u>Bartl.</u>	<u>1930</u>			Geol.						
L.				Contr.						
K.C.				Shira Drlg.						
B.K.C.				Pool						
Ce.				Madison						
C.				<table border="1"> <tr> <td colspan="2">ABANDONED</td> </tr> <tr> <td colspan="2">0</td> </tr> <tr> <td colspan="2">MAY 22 '57</td> </tr> </table>	ABANDONED		0		MAY 22 '57	
ABANDONED										
0										
MAY 22 '57										
M.										
M.										
K.										
Mz.										
Me.										
V.										
S.										
S.										
A.										
R.										
Pe.										
G.										
T.D.	<u>1956</u>									

Date Comm. 5-4-57
8" @ 150/100, Drlg. 671 MAY 15 '57 CID
1936-56 sec 20' sd 5 1/2
1936/40 MAY 22 '57 CO 1956 T.D
\$ 13 BSwph + 2 Goph.
D & W

County Greenwood Elev. _____
 Sec. 32 Twp. 22 Rge. 11E
 Company John Riley (Eureka)
 Farm Name Cragen No. 1

TOPS	DEPTH	LOG	DATUM	Loc. in Sec.						
Anh.				SW SW NE						
Tr.				450' fcl-450'						
H.				fsl NE $\frac{1}{4}$						
Tr.				Geol. _____						
Dg.				Contr. _____						
Bl.				Shira Drlg.						
L.				Pool _____						
K.C.				Madison						
B.K.C.				<table border="1"> <tr><td colspan="2">FIRST REPORT</td></tr> <tr><td colspan="2">0</td></tr> <tr><td colspan="2">MAY 8 '57</td></tr> </table>	FIRST REPORT		0		MAY 8 '57	
FIRST REPORT										
0										
MAY 8 '57										
Ce.										
C.										
M.										
M.										
K.										
Mz.										
Me.										
V.										
S.										
S.										
A.										
R.										
PC.										
G.										
T.D.										

Date Comm. 5-4-57
8" @ 150/100, Drlg. 671



Co.
Lse.
No.
Sec.
T.
R.