


✓

Map No. Kans Sec. 32 Twp. 22 R. 11

Well No. 9 (A) De Malouie Farm
York State Company

NORTH

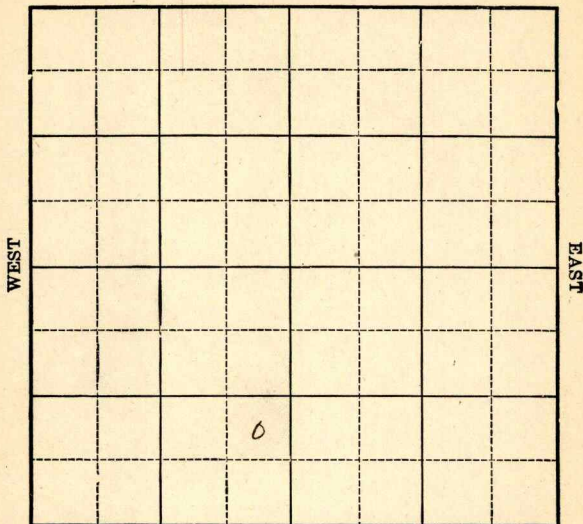

14

SOUTH

Location _____

Drilling Remarks _____

Rig Up _____

Drilling Remarks _____

RECORD

Cased _____ in. _____ ft.
Sand _____
Gas _____
Oil _____
Total Depth _____

PRODUCTION

1st 24 hrs. Nat. _____
1st. 24 hrs. after shot _____
Gas _____ cu. ft.
Dry Hole _____
Abandoned _____

Map No. ²¹ **KANSAS** Sec. 32 Twp. 22 R. 11

Well No. 9-(A) Loe Malarie

York State Company

Contractor

#4 should be
990 from S. + 990 from E

SECTION PLAT

		0	

_____ Ft. from N. Line

990 Ft. from S. Line

330 Ft. from E. Line

_____ Ft. from W. Line

FIRST REPORT

Location _____

Rig up

Drilling and Remarks:

RECORD

Cased _____ in., _____ ft.

Sand _____

Gas _____

Oil _____

Total Depth _____

PRODUCTION

1st 24 hrs. Nat. _____

1st 24 hrs. after shot _____

Gas _____ Cu. Ft.

Dry Hole _____

Abandoned _____

Date _____

3/24 1925

M. A. BENEAR

_____ Scout

Map No. 21 Rhdw Sec. 32 Twp. 22 R. 11

Well No. 9# De Melorio

YORK STATES OIL CO. Company

Contractor

COMPLETED

SECTION PLAT

----- Ft. from N. Line

990 Ft. from S. Line

330 Ft. from E. Line

----- Ft. from W. Line

	o		

Location -----

Rig up -----

Drilling and Remarks:

120 / 250 bbls

RECORD

Cased _____ in., _____ ft.

Sand 1905-1968

Gas -----

Oil -----

Total Depth -----

PRODUCTION

1st 24 hrs. Nat. -----

1st 24 hrs. after shot -----

Gas ----- Cu. Ft.

Dry Hole -----

Abandoned -----

Date

MAY 1 1925

CHAS. L. SHERWOOD

192 Scout