


Section 32 Township 22 Range 11E

Well No. A-15 York-DeMalorie

Company Phillips Pet.

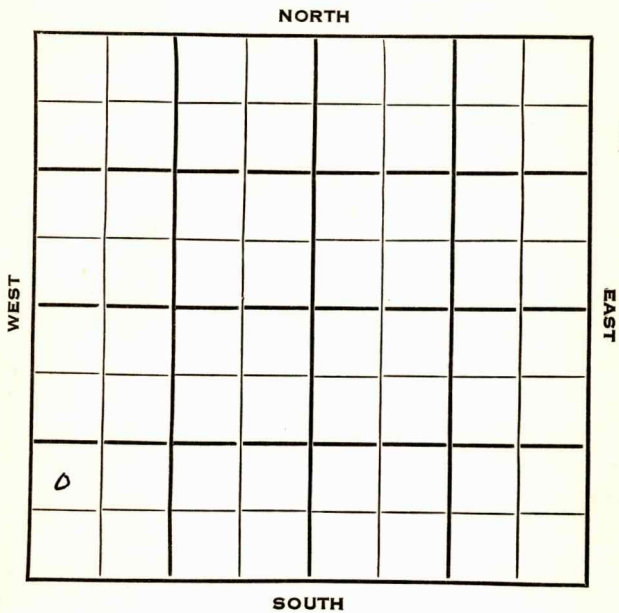

Sec. 32 Twp. 22 R. 11E

Well No. A-15 York DeMatorie Farm

Phillips Petroleum Company

Contractor


Ft. from N. Line

1316 Ft. from S. Line

Ft. from E. Line

61 Ft. from W. Line

NW SW SW

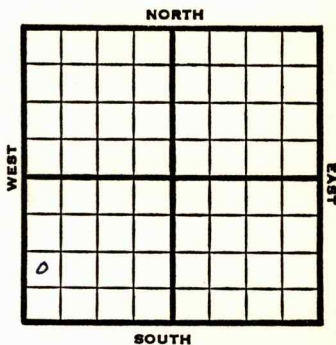

1952

Elev. - REPORT

12/30

Spudding 12/23/52, 8" @ 78
Drlg. 1940

1953
2/4

Spud 12-23-52
Oil Well
TD 1992
8" @ 78
Bart 1906, Sd 1960
TD 1967
5" @ 1960
DD 1992 60 qt 1965-88, 4 bopd
10 qt 1967 CO to 1989
S/37 bo 17 bw 4 hrs.
P/84 bo 13 bwpd
Comp. 45 bopd 10 bw

COMPLETED

