
Form 51 5M 8-24 16567

Map No. Kans Sec. 32 Twp. 22 R. 11E

Well No. 2 "C" De Maloine Farm

York State Company

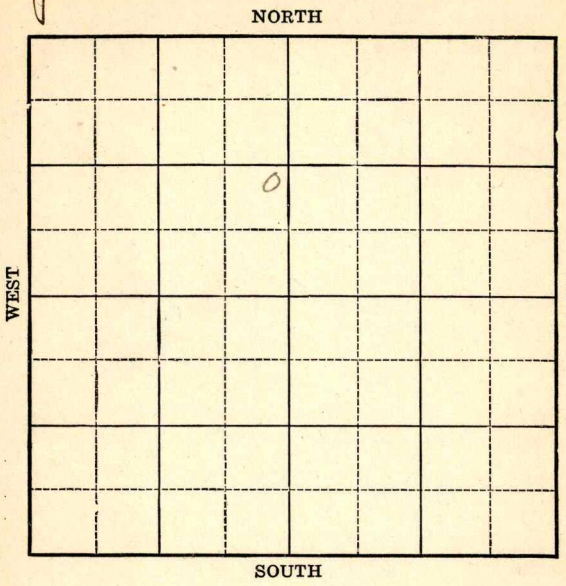

6


Location	Rig Up
Drilling Remarks	Drilling Remarks
RECORD	PRODUCTION
Cased in. ft.	1st 24 hrs. Nat.
Sand	1st. 24 hrs. after shot
Gas	Gas cu. ft.
Oil	Dry Hole
Total Depth	Abandoned

Form 252A 5M 8-24 16529

Map No. Kansas Sec. 32 Twp. 22 R 11E

Well No. 2C D.E. Malaker Farm

York States Company

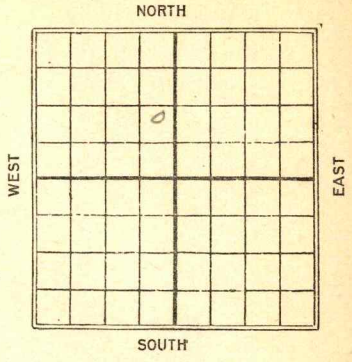

Ft. from N. Line

990 Ft. from S. Line

330 Ft. from E. Line

Ft. from W. Line

Date	REPORT
1925	
4/10	Rig up
5/15	Top sand 1941
	T.D. 2006 140 gts
	400 Blds

Form 26—1M Bks.—3-23—11959.

Map No. NhAa Sec. 32 Twp. 22 R. 11


Well No. 2 "C" De Malorio

York States Company

Contractor

COMPLETED

SECTION PLAT

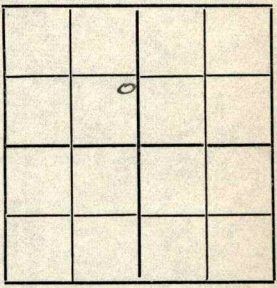

Ft. from N. Line

990 Ft. from S. Line

330 Ft. from E. Line

Ft. from W. Line

Location

Rig up

Drilling and Remarks:

Top 20 1941' 1st oil
1967-2006

1409/400 b/s

RECORD

Cased in., ft.

Sand

Gas

Oil

Total Depth 2006 m 20

PRODUCTION

1st 24 hrs. Nat.

1st 24 hrs. after shot

Gas Cu. Ft.

Dry Hole

Abandoned

Date

MAY 15 1925

192 CHAS. L. SHERWOOD Scout

Form 26—1M Bks.—3-23—11959.

Map No. 2 (Chalks) Sec. 32 Twp. 22 R. 11 E


Well No. 2 "C" De Nobles

York States Company

Contractor

FIRST REPORTS

SECTION PLAT

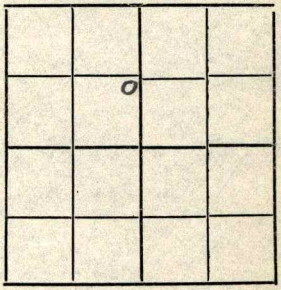

Ft. from N. Line

990 Ft. from S. Line

330 Ft. from E. Line

Ft. from W. Line

Location

Rig up ✓

Drilling and Remarks:

RECORD

Cased in., ft.

Sand

Gas

Oil

Total Depth

PRODUCTION

1st 24 hrs. Nat.

1st 24 hrs. after shot

Gas Cu. Ft.

Dry Hole

Abandoned

Date

APR 10 1925

192

Chas L Sherwood Scout