



Map No. Kansas Sec. 32 Twp. 22 R. 11


Well No. 11<sup>c</sup> De Malarie Farm  
York State Oil Co. Company

330 Ft. from N. Line

\_\_\_\_\_ Ft. from S. Line

990 Ft. from E. Line

\_\_\_\_\_ Ft. from W. Line

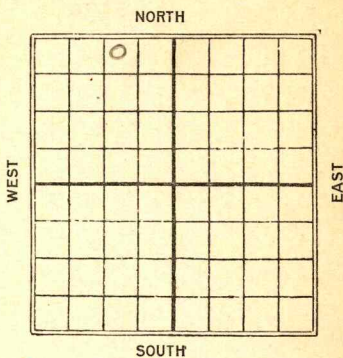

C.S.

Date	REPORT
<u>1925</u>	
<u>6/10</u>	<u>Location</u>
<u>6/5</u>	
<u>6/12</u>	_____
<u>6/19</u>	<u>Oldy req</u>
<u>6/26</u>	<u>Rigged up</u>
<u>7/3</u>	_____
<u>7/10</u>	<u>Rigged up &amp; S.D.</u>
<u>7/17</u>	_____
<u>7/24</u>	_____
<u>7/31</u>	_____
<u>8/7</u>	_____
<u>8/14</u>	_____
<u>8/20</u>	_____
<u>8/30</u>	_____
<u>9/3</u>	_____
<u>9/11</u>	_____
<u>9/16</u>	_____
<u>9/24</u>	_____
<u>10/1</u>	_____
<u>10/8</u>	_____

10/16 Rigged up + SD

10/22 \_\_\_\_\_

10/29 \_\_\_\_\_

11/6 \_\_\_\_\_

11/13 \_\_\_\_\_

11/19 \_\_\_\_\_

11/27 \_\_\_\_\_

12/3 \_\_\_\_\_

12/10 \_\_\_\_\_

12/17 \_\_\_\_\_

12/23 \_\_\_\_\_

12/31 \_\_\_\_\_

1926

1/6 \_\_\_\_\_

1/14 \_\_\_\_\_

1/20 \_\_\_\_\_

1/27 \_\_\_\_\_

2/4 \_\_\_\_\_

2/10 \_\_\_\_\_

2/17 \_\_\_\_\_

2/24 abd. Location

*Sherwood Co*

*R21* Map No. **KANSAS** Sec. *32* Twp. *22* R. *11*

Well No. *1/c Demolition*

*York State Oil Co* Company

Contractor

COMPLETED

SECTION PLAT

*330*

----- Ft. from N. Line

----- Ft. from S. Line

*990*

----- Ft. from E. Line

----- Ft. from W. Line

ABANDONED

	o		

Location -----

Rig up -----

Drilling and Remarks:

*old location -*

RECORD

Cased ----- in., ----- ft.

Sand -----

Gas -----

Oil -----

Total Depth -----

PRODUCTION

1st 24 hrs. Nat. -----

1st 24 hrs. after shot -----

Gas ----- Cu. Ft.

Dry Hole -----

Abandoned *location* -----

Date

FEB 24 1926

CHAS. L. SHERWOOD

192 Scout

Map No. 15000 Sec. 32 Twp. 22 R. 11

Well No. 110 De Malotie

York States Oil Co Company

Contractor

**FIRST REPORTS**

**SECTION PLAT**

330

Ft. from N. Line

Ft. from S. Line

990

Ft. from E. Line

Ft. from W. Line

	0		

Location

Rig up

Drilling and Remarks:

**RECORD**

Cased \_\_\_\_\_ in., \_\_\_\_\_ ft.

Sand \_\_\_\_\_

Gas \_\_\_\_\_

Oil \_\_\_\_\_

Total Depth \_\_\_\_\_

**PRODUCTION**

1st 24 hrs. Nat. \_\_\_\_\_

1st 24 hrs. after shot \_\_\_\_\_

Gas \_\_\_\_\_ Cu. Ft.

Dry Hole \_\_\_\_\_

Abandoned \_\_\_\_\_

Date

JUN 5

1925

192

**CHAS. L. SHERWOOD**

Scout