

Greenwood

Form 51-5M-11-38-Palace


KANSAS

Section 32 Township 22- Range 11-E

Well No. "C 6 W" Demalorie

Company York State

NORTH Madison Pool

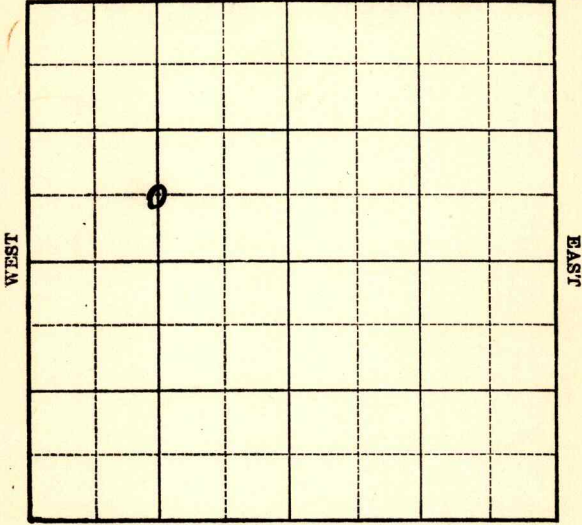

Sec. 32 Twp. 22 R. 11-E

Well No. # "C 6 W" Demajorie Farm

York State

Company


(Madison)

         Ft. from N. Line

660 Ft. from S. Line

         Ft. from E. Line

1320 Ft. from W. Line

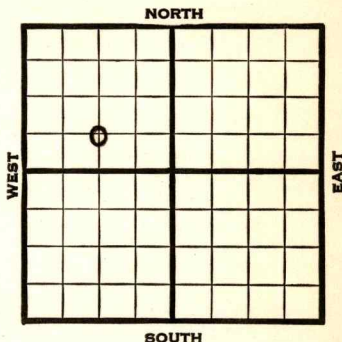

1939	REPORT
6/28	Location
7/6	Machine.
7/13	Drlg. 500'
7/20	10" - 700' 8" - 885'
	Drlg. 1110'
7/27	SD 1110'
8/3	6" - 1700' <b>Bart. 1955'</b>
	5" - 1955' T.D. 2040'
	Shot 40 qts. 1974-2020'
8/10	C. O. 200' oil.
8/16	<b>Bart. 1955'</b>
	5" - 1955'
	T.D. 2040'
	P. B. to 2020'
	Shot 40 qts. 1974-2020'
	20 bbls. oil.
	<b>COMPLETED</b>

Map No. 21 Sec. 32 Twp. 22 R. 11E

Well No. "C 6 W" Demalorie

York State

Company \_\_\_\_\_

Contractor \_\_\_\_\_

**FIRST REPORT**

**C S $\frac{1}{2}$  NW**

\_\_\_\_\_ Ft. from N. Line

660 Ft. from S. Line

\_\_\_\_\_ Ft. from E. Line

1320 Ft. from W. Line

**MADISON POOL**

**SECTION PLAT**

	o		

Location X

Rig up \_\_\_\_\_

Drilling and Remarks:

**RECORD**

Cased \_\_\_\_\_ in., \_\_\_\_\_ ft.

Sand \_\_\_\_\_

Gas \_\_\_\_\_

Oil \_\_\_\_\_

Total Depth \_\_\_\_\_

**PRODUCTION**

1st 24 hrs. Nat. \_\_\_\_\_

1st 24 hrs. after shot \_\_\_\_\_

Gas \_\_\_\_\_ Cu. Ft.

Dry Hole \_\_\_\_\_

Abandoned \_\_\_\_\_

Date

JUN 28 1939 19

S. J. LEWIS

Scout

Map No. 21 Sec. 32 Twp. 22 R. 11E

Well No. "C 6 W" Demalorie

York State Company

Contractor

**COMPLETED**

C S $\frac{1}{2}$  NW

**SECTION PLAT**

	o		

         Ft. from N. Line

660 Ft. from S. Line

         Ft. from E. Line

1320 Ft. from W. Line

**MADISON POOL**

Location                                 

Rig up                                 

Drilling and Remarks:

*Bar 8. 1955*  
*5" @ 1955.*  
*P. B 2020*  
*Bl. & 409 to 1974 - 2*  
*2020*  
*20 8/16*

**RECORD**

Cased          in.,          ft.

Sand                                 

Gas                                 

Oil                                 

Total Depth 2040

**PRODUCTION**

1st 24 hrs. Nat.                         

1st 24 hrs. after shot                         

Gas                                  Cu. Ft.

Dry Hole                                 

Abandoned                                 

Date

AUG 16 1939

19

S. J. LEWIS Scout