


Section 33 Township 22 Range 1E

Well No. 1 Hudson

Company G.L. Reasor

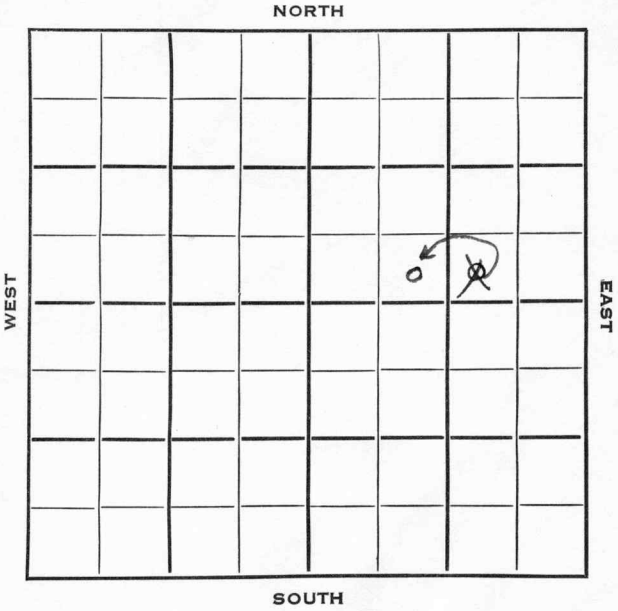



Sec. 33 Twp. 22 R. 1 E

Well No. # 1 Hudson Farm

G. L. Reasor Company


Prime Drlg. Contractor  
Wildcat

Ft. from N. Line

330 Ft. from S. Line

~~990~~ Ft. from E. Line

990 Ft. from W. Line

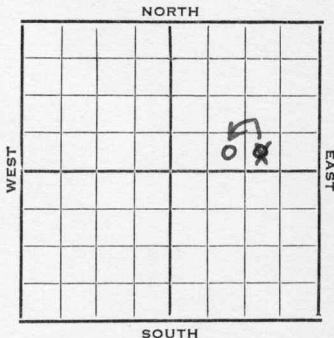

~~SW SE NE~~  
~~SE SW NE~~

1953

Elev. 1467' REPORT

4/8  
4/29

RUR  
Spud 4-9-53  
D & A  
TD 3606'  
8" @ 154'  
Lans 2318, Miss 2971, Kh 3273, Misener  
3382, Nunton 3384, Maq. 3461, Viola  
3471, Simp 3524, Arb 3595  
TD 3606'  
D & A

**ABANDONED**

County Harvey State Kansas

Sec. 33 (Blk. Twp.) 22 (Sur. Rge.) 1E Map No.

Operator G. L. Reasor

Well No. 1 Farm Hudson

Elev. \_\_\_\_\_ Location SW SE NE


330 Ft. From S Line NE

990 Ft. From E Line Quarter

1st. Report APR 8 1953

Completion \_\_\_\_\_

Remarks \_\_\_\_\_

Prime Drlg. - Contr.

Spudding Date \_\_\_\_\_

Drlg. Data Wildcat

RUR

Kansas

Map No. \_\_\_\_\_ Sec. 33 Twp. 22 R. 1E

Well No. 1 Hudson

G. L. Reasor Company

CORRECTION Contractor

SE SW NE

SECTION PLAT

\_\_\_\_\_ Ft. from N. Line

330 Ft. from S. Line

\_\_\_\_\_ Ft. from E. Line

990 Ft. from W. Line

		0	

Harvey County

Location \_\_\_\_\_

Rig up \_\_\_\_\_

Drilling and Remarks:

Reported  
SW SE NE

RECORD

Cased \_\_\_\_\_ in., \_\_\_\_\_ ft.

Sand \_\_\_\_\_

Gas \_\_\_\_\_

Oil \_\_\_\_\_

Total Depth \_\_\_\_\_

PRODUCTION

1st 24 hrs. Nat. \_\_\_\_\_

1st 24 hrs. after shot \_\_\_\_\_

Gas \_\_\_\_\_ Cu. Ft.

Dry Hole \_\_\_\_\_

Abandoned \_\_\_\_\_

Date

J. G. McGEHEE

APR 15 1952

Scout

