

Greenwood ✓


Form 51-5M-11-31-Palace

Map No. **KANSAS** Sec. *23* Twp. *22* R. *11* ^E

Well No. *14 Westcott* Farm

York State Company

NORTH

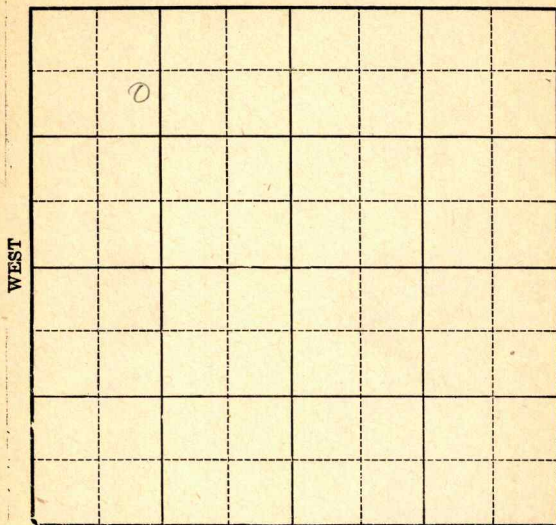

Location _____

Drilling Remarks _____

Rig Up _____

Drilling Remarks _____

RECORD

Cased _____ in. _____ ft.

Sand _____

Gas _____

Oil _____

Total Depth _____

PRODUCTION

1st 24 hrs. Nat. _____

1st 24 hrs. after shot _____

Gas _____ cu. ft.

Dry Hole _____

Abandoned _____

Greenwood

Map No. **KANSAS** Sec. 33 Twp 22 R. 11E


Well No. 14 Westcott Farm
York State Company

760 Ft. from N. Line

_____ Ft. from S. Line

_____ Ft. from E. Line

1120 Ft. from W. Line

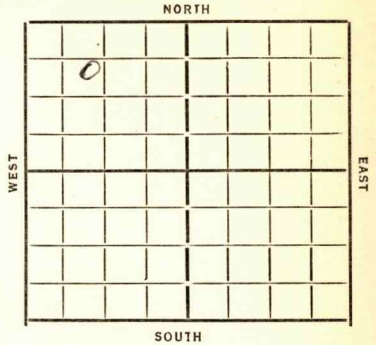

Date 1933

REPORT

10/4 Spud
10/11 reg 920
10/18 " 1350
10/25 " 1765
11/1 sand 1924-2001 T.D. 2004 1/2
 shot 160 gts 35 bbls 10 bbls
 water

COMPLETED

Map No. 21 Sec. 33 Twp. 22 R. 11E

Well No. 14 - Westcott

York State Company

Contractor

SECTION PLAT

760 Ft. from N. Line

..... Ft. from S. Line

..... Ft. from E. Line

1120 Ft. from W. Line

o			

Location.....

Rig up.....

Drilling and Remarks:

Spud

RECORD

Cased..... in., ft.

Sand.....

Gas.....

Oil.....

Total Depth.....

PRODUCTION

1st 24 hrs. Nat.....

1st 24 hrs. after shot.....

Gas..... Cu. Ft.

Dry Hole.....

Abandoned.....

Date

10-4-33 192.....

O. Mannheim Secut

Greenwood

Map No. *21* Sec. *33* Twp. *22* R. *11E*

Well No. *14 - Westcott*

York State Company

Contractor

SECTION PLAT

760 Ft. from N. Line

..... Ft. from S. Line

..... Ft. from E. Line

1120 Ft. from W. Line

<i>0</i>			

COMPLETED

Location.....

Rig up.....

Drilling and Remarks:

160 gts

*35 oil
10 water*

RECORD

Cased..... in. ft.

Sand *1924-2001*

Gas.....

Oil.....

Total Depth *2004 1/2*

PRODUCTION

1st 24 hrs. Nat.....

1st 24 hrs. after shot.....

Gas..... Cu. Ft.

Dry Hole.....

Abandoned.....

Date

11-1-33 192

O. J. Mannhuber Scout