



*Greenwood*

Map No. \_\_\_\_\_ Sec. 33 Twp 22 R. 11E

**KANSAS**

Well No. 15-Westcott Farm \_\_\_\_\_


York State Company \_\_\_\_\_

1320 Ft. from N. Line

\_\_\_\_\_ Ft. from S. Line

\_\_\_\_\_ Ft. from E. Line

660 Ft. from W. Line

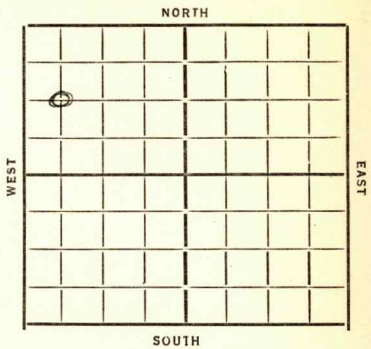

Date 1933

REPORT

10/4 Spud

10/11 Drig 1010

10/18 " 1585

10/25 sand 1941-2002 - 400' oil in hole

11/1 sand 1941-2002 T.D., 6 bbls oil

30 bbls water

**COMPLETED**

*Greenwood*  
 Map No. 21 Sec. 33 Twp. 22 R. 11E  
 Well No. 15-Westcott  
York State Company

Contractor

**SECTION PLAT**

1320 Ft. from N. Line

..... Ft. from S. Line

..... Ft. from E. Line

660 Ft. from W. Line

|   |  |  |  |
|---|--|--|--|
|   |  |  |  |
| o |  |  |  |
|   |  |  |  |
|   |  |  |  |

Location.....

Rig up.....

Drilling and Remarks:

*Spud*

**RECORD**

Cased..... in., ..... ft.

Sand.....

Gas.....

Oil.....

Total Depth.....

**PRODUCTION**

1st 24 hrs. Nat.....

1st 24 hrs. after shot.....

Gas..... Cu. Ft.

Dry Hole.....

Abandoned.....

Date

10-4-33 192 O. Mannich Scout

*Greenwood*  
Map No. 21 Sec. 33 Twp. 22 R. 11 E  
Well No. 15- Westcott  
York State Company

Contractor

SECTION PLAT

1320 Ft. from N. Line  
..... Ft. from S. Line  
..... Ft. from E. Line  
660 Ft. from W. Line

|          |  |  |  |
|----------|--|--|--|
|          |  |  |  |
| <i>e</i> |  |  |  |
|          |  |  |  |
|          |  |  |  |

**COMPLETED**

Location.....  
Rig up.....  
Drilling and Remarks:

*6 oil  
30 water*

RECORD

Cased..... in., ..... ft.  
Sand 1941-2002  
Gas.....  
Oil.....  
Total Depth 2002

PRODUCTION

1st 24 hrs. Nat.....  
1st 24 hrs. after shot.....  
Gas..... Cu. Ft.  
Dry Hole.....  
Abandoned.....

Date

11-1-33 192 O. Mannedreck Scout