



*Greenwood*

Map No. **KANSAS** Sec. *33* Twp *22* R. *11E*

Well No. *16 Westcott* Farm


*York State Oil* Company

*200'* Ft. from N. Line

\_\_\_\_\_ Ft. from S. Line

\_\_\_\_\_ Ft. from E. Line

*1120'* Ft. from W. Line

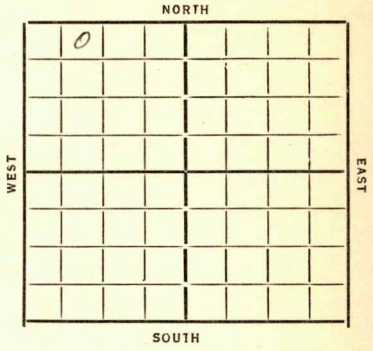

REPORT

Date *1933*

*11/15 Location*

*11/23 Machine*

*11/29 Drlg 400'*

*12/6 " "*

*12/13 " 1600*

*12/27 S.D 1993*

*(1934)*

*1/2 Sand 1961-90' J.D. 1993'*

*Shot 20 g to 30 lbs*

**COMPLETED**

*Granwood*  
Map No. 21 Sec. 33 Twp. 22 R. 11E

Well No. 16 - Westcott  
York State Oil Company

Contractor

**COMPLETED**

SECTION PLAT

°			

200 Ft. from N. Line

..... Ft. from S. Line

..... Ft. from E. Line

1120 Ft. from W. Line

Location.....

Rig up.....

Drilling and Remarks:

50 gts

30 bbls

RECORD

Cased..... in., ..... ft.

Sand 1961-90

Gas.....

Oil.....

Total Depth 1993

PRODUCTION

1st 24 hrs. Nat.....

1st 24 hrs. after shot.....

Gas..... Cu. Ft.

Dry Hole.....

Abandoned.....

Date

1-3-34 192 O. Manschreck Scout

Map No. 21 Sec. 33 Twp. 22 R. 11E

Well No. 16 - Westcott

York State Oil Company

Contractor

**FIRST REPORTS**

**SECTION PLAT**

200 Ft. from N. Line

..... Ft. from S. Line

..... Ft. from E. Line

1120 Ft. from W. Line

0			

Location..... ✓

Rig up.....

Drilling and Remarks:

**RECORD**

Cased..... in., ..... ft.

Sand.....

Gas.....

Oil.....

Total Depth.....

**PRODUCTION**

1st 24 hrs. Nat.....

1st 24 hrs. after shot.....

Gas..... Cu. Ft.

Dry Hole.....

Abandoned.....

Date

11-15-33 192 D. Mannschreck Scout