


Map No. Kansas Sec. 33 Twp. 22 R. 11 ✓
Well No. 5 Greenwood Farm
Tennings Company

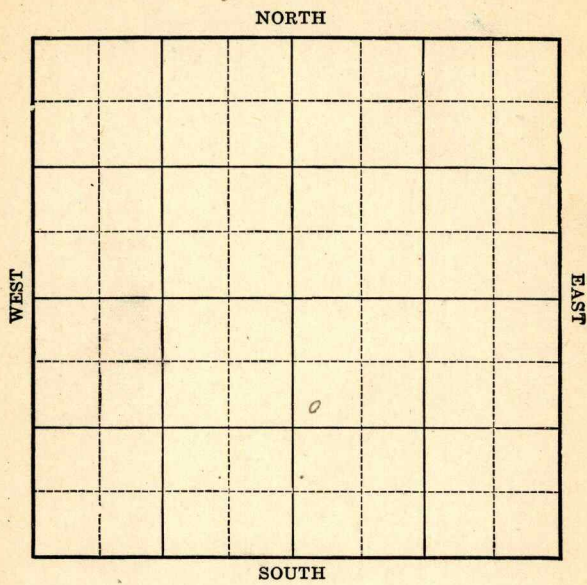

Location _____
Drilling Remarks _____

Rig Up _____
Drilling Remarks _____

RECORD

Cased _____ in. _____ ft.
Sand _____
Gas _____
Oil _____
Total Depth _____


PRODUCTION

1st 24 hrs. Nat. _____
1st. 24 hrs. after shot _____
Gas _____ cu. ft.
Dry Hole _____
Abandoned _____

Map No. Kansas Sec. 33 Twp. 22 R. 11Well No. 5 Greenwood FarmTennings Company1120 Ft. from N. Line

Ft. from S. Line

Ft. from E. Line

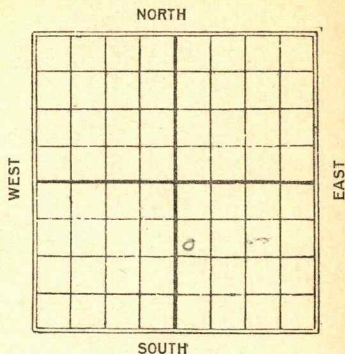300 Ft. from W. Line

Date

REPORT

19253/1R. O. G.4/171898-1933120 gts60 bbls

Map No. 21 16nd Sec. 33 Twp. 22 R. 11

Well No. 5 Johnson

Jennings Bros Company

Contractor

COMPLETED

SECTION PLAT

1180 Ft. from N. Line

_____ Ft. from S. Line

_____ Ft. from E. Line

300 Ft. from W. Line

		0	

Location _____

Rig up _____

Drilling and Remarks:

120y 60 bbls

RECORD

Cased _____ in., _____ ft.

Sand 1898-1933

Gas _____

Oil _____

Total Depth _____

PRODUCTION

1st 24 hrs. Nat. _____

1st 24 hrs. after shot _____

Gas _____ Cu. Ft.

Dry Hole _____

Abandoned _____

Date

APR 17 1925

_____ 192_____

Chs. L. Sherwood Scout

21 **KANSAS** Sec. 33 Twp. 22 R. 11

Well No. 5—Greenwood

Jennings Company

Contractor

FIRST REPORT

1120 Ft. from N. Line

_____ Ft. from S. Line

_____ Ft. from E. Line

300 Ft. from W. Line

SECTION PLAT

		o	

Location _____

Rig up _____

Drilling and Remarks:

R.O.S.

RECORD

Cased _____ in., _____ ft.

Sand _____

Gas _____

Oil _____

Total Depth _____

PRODUCTION

1st 24 hrs. Nat. _____

1st 24 hrs. after shot _____

Gas _____ Cu. Ft.

Dry Hole _____

Abandoned _____

Date

3/1

1925

M. A. BENEAR

Scout