


Map No. _____ Sec. 33 Twp. 22 R. 11
Well No. 1 Westcott Farm _____
York State Company _____

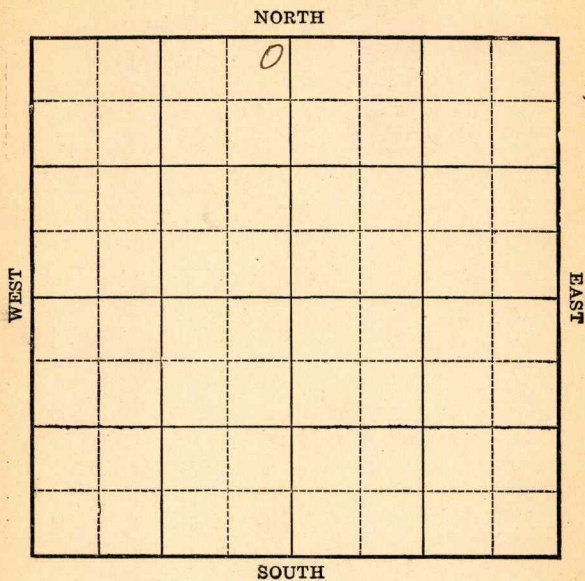

Location _____

Drilling Remarks:

RECORD

Cased _____ in. _____ ft.

Sand _____

Gas _____

Oil _____

Total Depth _____

Rig up _____

Drilling Remarks:

PRODUCTION

1st 24 hrs Nat. _____

1st 24 hrs. after shot _____

Gas _____ cu. ft.

Dry Hole _____

Abandoned _____

Map No. _____ Sec. 33 Twp. 22 R. 11


Well No. 1 Westcott Farm _____
York State Company _____

200 Ft. from N. Line

_____ Ft. from S. Line

_____ Ft. from E. Line

200 Ft. from W. Line

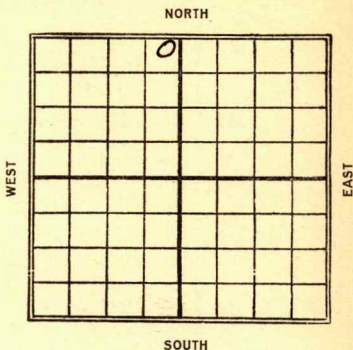

Date
1925

REPORT

1/12 Sand 1956-79- Est.
50 lbs. Looks little
light.

Map No. **KANSAS** ²¹ Sec. **33** Twp. **22** R. **11**

Well No. **1 Wiscott**

York State Company
Completed

~~ABANDONED~~ Contractor

FIRST REPORT

SECTION PLAT

200 Ft. from N. Line

----- Ft. from S. Line

----- Ft. from E. Line

200 Ft. from W. Line

	0		

Location -----

Rig up -----

Drilling and Remarks:

*sand 1956
1979
looks little
light
est. 50 lbs*

RECORD

Cased ----- in., ----- ft.

Sand -----

Gas -----

Oil -----

Total Depth -----

PRODUCTION

1st 24 hrs. Nat. -----

1st 24 hrs. after shot -----

Gas ----- Cu. Ft.

Dry Hole -----

Abandoned -----

Date

JAN 12 1923
191

M. A. BENEAR

Scout