

Map No. \_\_\_\_\_ Sec. 33 Twp. 22 R. 11

Well No. *8 Westcott* Farm

R. J. Gillespie Company

NORTH

WEST

# EAST

**SOUTH**

**Location** \_\_\_\_\_

**Drilling Remarks:**

Rig up \_\_\_\_\_

**Drilling Remarks:**

## RECORD

Cased\_\_\_\_\_in.\_\_\_\_\_ft.

**Sand** \_\_\_\_\_

Gas \_\_\_\_\_

Oil \_\_\_\_\_

Total Depth\_\_\_\_\_

## PRODUCTION

1st 24 hrs Nat.

1st 24 hrs. after shot

Gas cu ft

### Dry Hole

## Abandoned

Map No. \_\_\_\_\_ Sec. 33 Twp. 22 R. 11  
 Well No. 8 Westcott Farm \_\_\_\_\_  
R. Y. Gillespie Company \_\_\_\_\_

NORTH

\_\_\_\_\_ Ft. from N. Line


946 Ft. from S. Line

\_\_\_\_\_ Ft. from E. Line

946 Ft. from W. Line

WEST

EAST

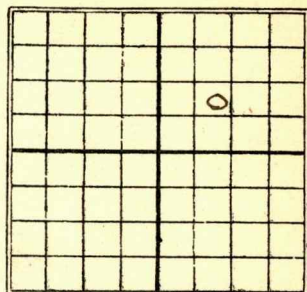

SOUTH

Date

REPORT

1923  
2/24 R.O.M.  
5/7 Sand 1933-67-Shot  
60 gts. 40 Bbls.

**KANSAS**

Map No. \_\_\_\_\_ Sec. 33 Twp. 22 R. 11

Well No. 8 Wescott

R. G. Gillispie Company

\_\_\_\_\_  
Contractor

**COMPLETED**

**SECTION PLAT**

|  |  |   |  |
|--|--|---|--|
|  |  |   |  |
|  |  | 0 |  |
|  |  |   |  |
|  |  |   |  |

\_\_\_\_\_  
Ft. from N. Line

946 \_\_\_\_\_  
Ft. from S. Line

\_\_\_\_\_  
Ft. from E. Line

946 \_\_\_\_\_  
Ft. from W. Line

Location \_\_\_\_\_

Rig up \_\_\_\_\_

Drilling and Remarks:

sand { 1933  
          { 1967  
60/40 bbb

**RECORD**

Cased \_\_\_\_\_ in., \_\_\_\_\_ ft.

Sand \_\_\_\_\_

Gas \_\_\_\_\_

Oil \_\_\_\_\_

Total Depth \_\_\_\_\_

**PRODUCTION**

1st 24 hrs. Nat. \_\_\_\_\_

1st 24 hrs. after shot \_\_\_\_\_

Gas \_\_\_\_\_ Cu. Ft.

Dry Hole \_\_\_\_\_

Abandoned \_\_\_\_\_

Date

**M. A. BENEAR**

MAY 7 1923  
191

Scout

Map No. **KANSAS** <sup>21</sup> Sec. **33** Twp. **23** R. **11**  
 Well No. **R. O. G.**  
**R. O. G. Gillispie** Company  
 Contractor

## FIRST REPORT

Ft. from N. Line  
**946** Ft. from S. Line  
 Ft. from E. Line  
**946** Ft. from W. Line

## SECTION PLAT

|  |  |   |  |
|--|--|---|--|
|  |  |   |  |
|  |  | 0 |  |
|  |  |   |  |
|  |  |   |  |

Location

Rig up

Drilling and Remarks:

**R. O. G.**

## RECORD

Cased \_\_\_\_\_ in., \_\_\_\_\_ ft.

Sand \_\_\_\_\_

Gas \_\_\_\_\_

Oil \_\_\_\_\_

Total Depth \_\_\_\_\_

## PRODUCTION

1st 24 hrs. Nat. \_\_\_\_\_

1st 24 hrs. after shot \_\_\_\_\_

Gas \_\_\_\_\_ Cu. Ft.

Dry Hole \_\_\_\_\_

Abandoned \_\_\_\_\_

Date

FEB 24 1923

191

M. A. BENEAR

Scout