

Map No. **KANSAS** Sec. 33 Twp. 22 R. 11^E

Well No. 12- Westcott Farm
York State Oil Company


1320 Ft. from N. Line

_____ Ft. from S. Line

_____ Ft. from E. Line

1120 Ft. from W. Line

1932

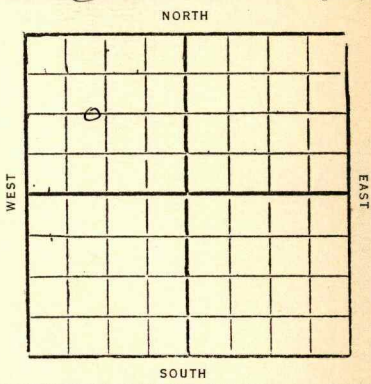

Date	REPORT
5/18	Drg 235'
5/25	Drg 700'
6/11	" 1400'
6/18	Top Sand 1925
	Drg 1934 sho oil
6/15	No report
6/22	Sand 1923-2003
	TD 2003
	shot 60 qt
	100 bbl

Greenwood

E

21 **KANSAS** Sec. 33 Twp. 22 R. 11

Well No. 12 Westcast

York State Oil Co Company

Contractor

FIRST REPORTS

1320 Ft. from N. Line

Ft. from S. Line

Ft. from E. Line

1120 Ft. from W. Line

SECTION PLAT

o			

Location

Rig up

Drilling and Remarks:

Apply 235

RECORD

Cased in., ft.

Sand

Gas

Oil

Total Depth

PRODUCTION

1st 24 hrs. Nat.

1st 24 hrs. after shot

Gas Cu. Ft.

Dry Hole

Abandoned

Date

MAY 1 8 1932

CHAS. L. SHERWOOD

Scout

Greenwood

21 KANSAS

Map No. Sec. 33 Twp. 22 R. 11 E

Well No. 12 Westcott

York State Oil Co Company

Contractor

COMPLETED

SECTION PLAT

1320 Ft. from N. Line

Ft. from S. Line

Ft. from E. Line

1120 Ft. from W. Line

Location

Rig up

Drilling and Remarks:

Shot 60'

100 Bls.

RECORD

Cased in., ft.

Sand 1923-2003

Gas

Oil

Total Depth 2003

PRODUCTION

1st 24 hrs. Nat.

1st 24 hrs. after shot

Gas Cu. Ft.

Dry Hole

Abandoned

Date

JUN 22 1932

192

CHAS. L. SHERWOOD

Scout