


Marion

KANSAS

SECTION 32 34 TOWNSHIP 22S RANGE 4E

WELL NO. #2 Jenson (Jensen)

COMPANY Progressive Oil

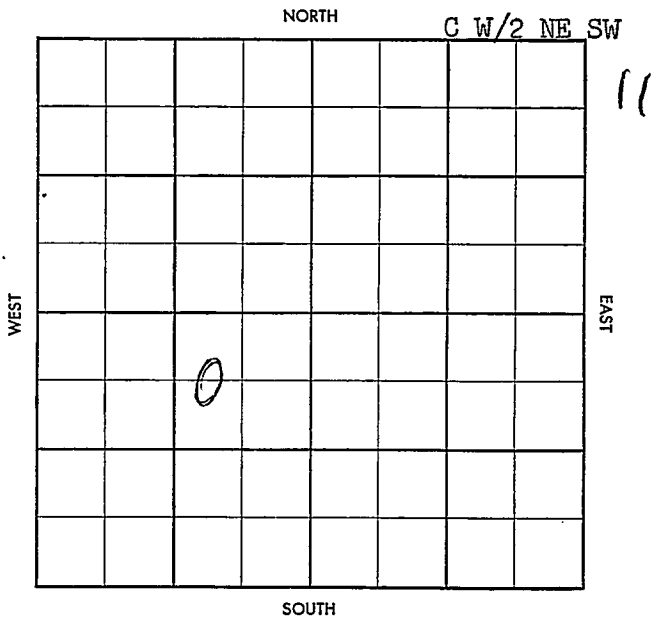

~~NO~~
CORRECTION

S-513-A

CO. Marion ELEV. 1435 of
SEC. 3/34 TWP. 22 RGE. 4E
COMPANY Progressive Oil NO. 2

COMPLETE

DEC 11 57

FARM Jenson

LOC. C W/2 NE 3W

GEOL. _____
 CONTR. Red Drl.
 POOL Edmonds
 SPUD 11/23/57
8" x 200' LC
L 1842 KC 2026
TD 2096 4 1/2"
2093 WOC
30/1950-55 SD
DD 2104 TD frac

no tests #01

3 15 BO QV + 50 BW

KC 2093 - 2104

CO
LSE
NO.
SEC.
TWP.
RGE.