


Map No. 1123 Sec. 34 Twp. 27 R. 4Well No. 2 Dogpen FarmThe Pure Oil Company

NORTH

WEST

EAST

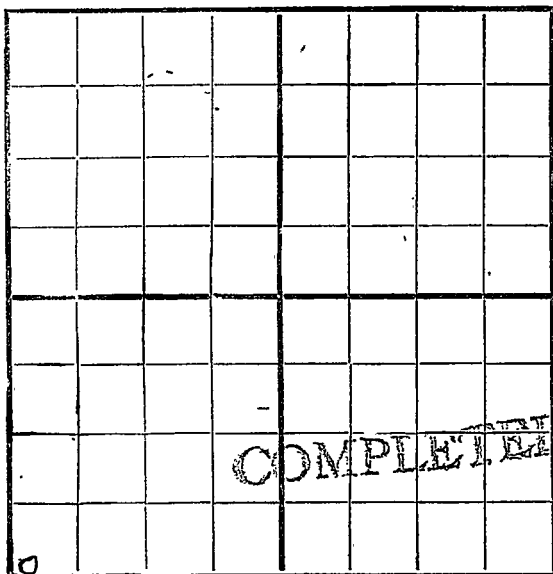

SOUTH

Location -----

Rig Up -----

Drilling Remarks:

Drilling Remarks:

RECORD

Cased.....in.ft.

Sand

Gas

Oil

Total Depth

PRODUCTION

1st 24 hrs. Nat.

1st 24 hrs. after shot


Gascu. ft.

Dry Hole

Abandoned

Map No. K 23 Sec. 34 Twp. 22 R. 4Well No. 2 Nonken FarmThe Pure Oil Company.

NORTH

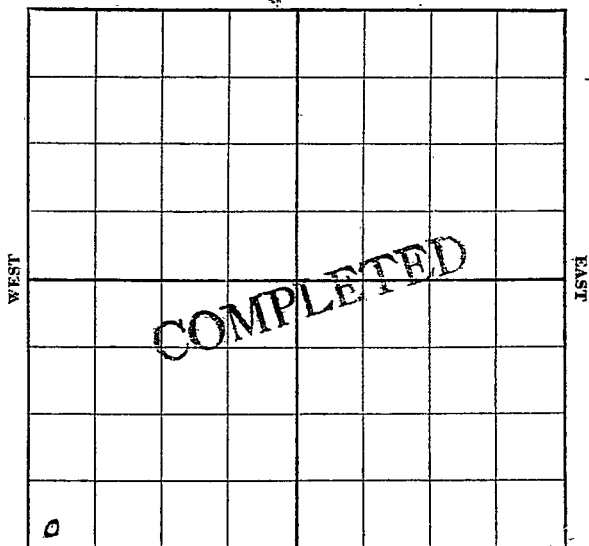200 S-W

SOUTH

Location

Rig up

Drilling and Remarks:

RECORD

Cased in., ft.

Sand 2102-2112

Gas

Oil

Total Depth

PRODUCTION

1st 24 hrs. Nat. 10 bbls

1st 24 hrs. after shot

Gas Cu. Ft.

Dry Hole

Abandoned

Date

Pyle

Scout.

7/26 1920