

Map No. _____ Sec. 3 4 Twp. 3 2 R. 4

Well No. 1 Nonken Farm _____
Ohio Cities Gas Company


N

(Nonken)

13

W

E

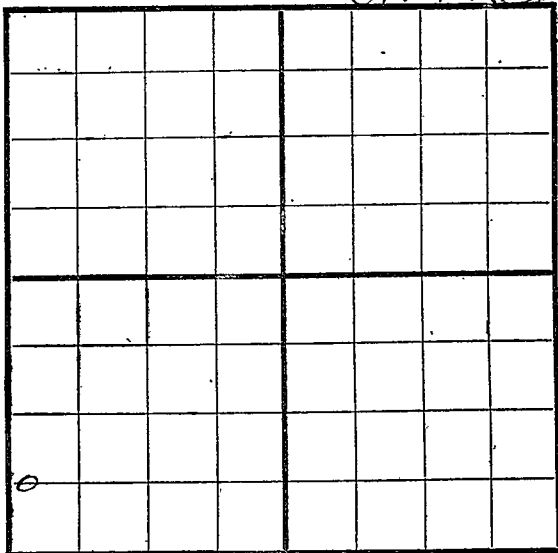

S

Location _____

Rig Up _____

Drilling Remarks:

Drilling Remarks:

COMPLETED

RECORD

PRODUCTION

Cased _____ in. _____ ft.

1st 24 hrs. Nat. _____

Sand _____

1st 24 hrs. after shot _____

Gas _____

Gas _____ cu. ft.

Oil _____

Dry Hole _____

Total Depth _____

Abandoned _____

Map No. _____ Sec. 34 Twp. 22 R. 4

Well No. 1 Houkin Farm

Ohio cities Gas Company

Contractor


Sw Quarter

Ft. from N. Line

669 Ft. from S. Line

Ft. from E. Line

200 Ft. from W. Line

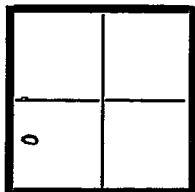

1929
Date

REPORT

11/17	Rig up	FIRST REPORT
24	Rig up.	
12/11	Rig	
8	Rig up.	COMPLETED
15	Rig up.	
22	" "	
31	Rig	
1/6/20	Rig	
13	Rig	
19	"	
26	Rig	
2/2	Land	
9	Spudding.	
16	Dlg 840'	
21	Dlg 1280'	
31	Dlg. 1430'	
8	8 1/2' - 1920	
15	Land 2104' - 19' - 800' Oil	
29	2104' - 19' - 600' water	

Map No. K 23 Sec. 34 Twp. 22 R. 4

Well No. 1 Nonkin

Ohio Cities Gas Company

Contractor

SECTION PLAT

FIRST REPORT

Ft. from N. Line

660 Ft. from S. Line

Ft. from E. Line

200 Ft. from W. Line

Location _____

Rig up

Drilling and Remarks:

RECORD

Cased _____ in., _____ ft.

Sand _____

Gas _____

Oil _____

Total Depth _____

PRODUCTION

1st 24 hrs. Nat. _____

1st 24 hrs. after shot _____

Gas _____ Cu. Ft.

Dry Hole _____

Abandoned _____

Date

11/17 1919

Pyle

Scout

Map No. K 23 Sec. 34 Twp. 22 R. 4

Well No. 1 Nonkin

Ohio Cities Gas Company

Contractor

SECTION PLAT

COMPLETED

_____ Ft. from N. Line

660 Ft. from S. Line

_____ Ft. from E. Line

200 Ft. from W. Line

Location _____

Rig up _____

Drilling and Remarks:

RECORD

Cased _____ in., _____ ft.

Sand 2104 - 19

Gas _____

Oil _____

Total Depth _____

PRODUCTION

1st 24 hrs. Nat. 60 bbls

1st 24 hrs. after shot _____

Gas _____ Cu. Ft.

Dry Hole _____

Abandoned _____

Date

3/29 1920

Pyle

Scout