


Map No. KANSAS Sec. 34 Twp. 22 R. 11<sup>E</sup>

Well No. 1-2 Harlow Farm  
G. J. O'Neil Company

NORTH Henderson & Holder

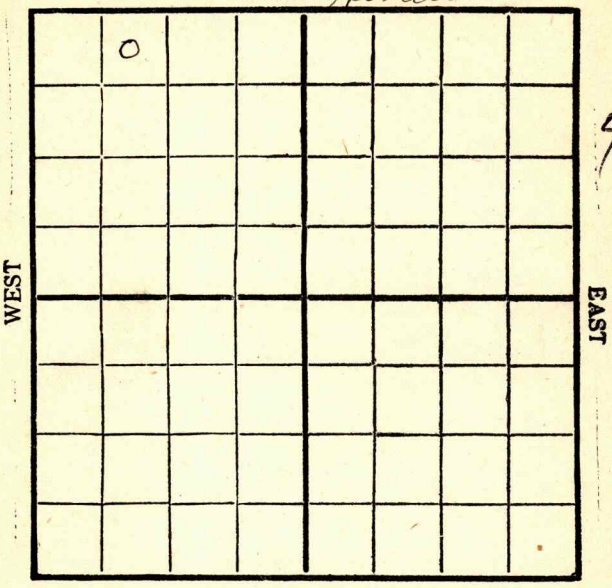

Location \_\_\_\_\_

Drilling Remarks \_\_\_\_\_

\_\_\_\_\_

\_\_\_\_\_

Rig Up \_\_\_\_\_

Drilling Remarks \_\_\_\_\_

\_\_\_\_\_

\_\_\_\_\_

RECORD

Cased \_\_\_\_\_ in. \_\_\_\_\_ ft.

Sand \_\_\_\_\_

Gas \_\_\_\_\_

Oil \_\_\_\_\_

Total Depth \_\_\_\_\_

PRODUCTION

1st 24 hrs. Nat. \_\_\_\_\_

1st 24 hrs. after shot \_\_\_\_\_

Gas \_\_\_\_\_ cu. ft. \_\_\_\_\_

Dry Hole \_\_\_\_\_

Abandoned \_\_\_\_\_

Map No. **KANSAS** Sec. 34 Twp. 22 R. 11E

Well No. 1 - Harlow Farm

G. J. O'Neil Company


Henderson & Holder NORTH

330 Ft. from N. Line

\_\_\_\_\_ Ft. from S. Line

\_\_\_\_\_ Ft. from E. Line

1070 Ft. from W. Line

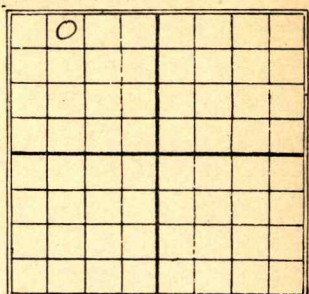

1930

Date	REPORT
2/26	Root
3/5	Bldg rig
3/12	Rig
3/19	Drlg. 650'
3/26	Drlg. 1000'
4/2	10" L 1055'
4/9	Sand 1865-1868'
	show oil.
4/16	Sand 1865-99
	Broken sand 1899-1929
	TD 1929
	shot 260 qt
	O 230 bbl oil
	- onp.

*Greenwood*

**KANSAS**

Map No. \_\_\_\_\_ Sec. *34* Twp. *22* R. *11* <sup>E</sup>

Well No. *1* *Harlow*

*G. F. O'Neil*

Company

Contractor

**FIRST REPORTS**

**SECTION PLAT**

*330* Ft. from N. Line

\_\_\_\_\_ Ft. from S. Line

\_\_\_\_\_ Ft. from E. Line

*1070* Ft. from W. Line

<i>0</i>			

Location *Pro G*

Rig up \_\_\_\_\_

Drilling and Remarks:

**RECORD**

Cased \_\_\_\_\_ in., \_\_\_\_\_ ft.

Sand \_\_\_\_\_

Gas \_\_\_\_\_

Oil \_\_\_\_\_

Total Depth \_\_\_\_\_

**PRODUCTION**

1st 24 hrs. Nat. \_\_\_\_\_

1st 24 hrs. after shot \_\_\_\_\_

Gas \_\_\_\_\_ Cu. Ft.

Dry Hole \_\_\_\_\_

Abandoned \_\_\_\_\_

Date

**FEB 26 1930**

*Greenwood*

Map No. **KANSAS** Sec. *34* Twp. *22* R. *11*

Well No. *1* *Harlow*

*G. J. O'Neil* Company

Contractor

**COMPLETE**

**SECTION PLAT**

*330* Ft. from N. Line

Ft. from S. Line

Ft. from E. Line

*1070* Ft. from W. Line

<i>0</i>			

Location.....

Rig up.....

Drilling and Remarks:

*Brown Sand*

*1899-1929*

*260/230 Bbs.*

**RECORD**

Cased..... in., ..... ft.

Sand *1865-1899*

Gas.....

Oil.....

Total Depth *1929*

**PRODUCTION**

1st 24 hrs. Nat.....

1st 24 hrs. after shot.....

Gas..... Cu. Ft.

Dry Hole.....

Abandoned.....

Date

**APR 16 1930**

192..... **CHAS. L. SHERWOOD** Scout

*Greenwood*

21 **KANSAS** E  
Map No. .... Sec. *34* Twp. *22* R. *11*

Well No. *Harlow*

*Henderson & Holden* Company

Contractor

*Completed wells*

**CORRECTION**

**SECTION PLAT**

..... Ft. from N. Line

..... Ft. from S. Line

..... Ft. from E. Line

..... Ft. from W. Line

*Previous Ownership  
G. F. O'Neil.*


Location .....

Rig up .....

Drilling and Remarks:

*change ownership  
of this lease  
to above.*

**RECORD**

Cased..... in., ..... ft.

Sand.....

Gas.....

Oil.....

Total Depth.....

**PRODUCTION**

1st 24 hrs. Nat.....

1st 24 hrs. after shot.....

Gas..... Cu. Ft.

Dry Hole.....

Abandoned.....

Date

**SEP 14 1932**

**CHAS. L. SHERWOOD**

192..... Scout