


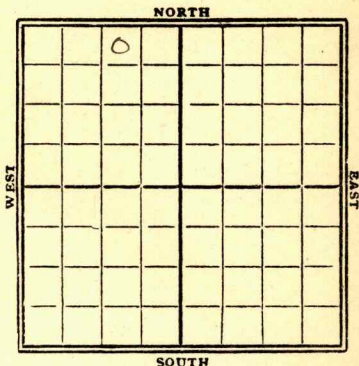

Greenwood  
 Map No. **KANSAS** Sec. 34 Twp. 22 R. 11<sup>E</sup>  
 Well No. 1-"H" Brinn Farm  
 Geo. O'Neil Company

330 Ft. from N. Line  
 \_\_\_\_\_ Ft. from S. Line  
 990 Ft. from E. Line  
 \_\_\_\_\_ Ft. from W. Line



1929

Date	REPORT
11/13	Location
11/20	
11/27	Rey
12/4	Run up
12/11	Spdy
12/23	Wrlg 930'
12/30	Fsg tools 935'
1930	
1/8	
1/15	set 10"-950' 5D
1/22	
1/29	Wrlg 1100'
2/4	S.D. 1100
2/11	Wrlg. 1365
2/19	" 1700
2/26	sandy shale 1879-82 sand 1882-1919 T.D. 1940' shot 100 qt swab 6 bbl per hr.
3/5	sandy shale 1879-82 sand 1882-1919 T.D. 1940' shot 100 qt 50 bbl oil

*Greenwood*

Map No. **KANSAS** Sec. *34* Twp. *22* R. *11 E*

Well No. *1 A* *Brinn*

*Geo O'Neil* Company

Contractor

**FIRST REPORTS**

*330* Ft. from N. Line

..... Ft. from S. Line

*990* Ft. from E. Line

..... Ft. from W. Line

**SECTION PLAT**

	<i>0</i>		

Location  .....  
Rig up.....  
Drilling and Remarks:

**RECORD**

Cased..... in., ..... ft.  
Sand.....  
Gas.....  
Oil.....  
Total Depth.....

**PRODUCTION**

1st 24 hrs. Nat.....  
1st 24 hrs. after shot.....  
Gas..... Cu. Ft.  
Dry Hole.....  
Abandoned.....

Date *11/13/29* 192.....

**CHAS. L. SHERWOOD**

Scout

Greenwood

21 **KANSAS** Map No. Sec. 34 Twp. 22 R. 11

Well No. 1 a. Brinn  
Geo O'Neil

Company

Contractor

**COMPLETE**

**SECTION PLAT**

330 Ft. from N. Line  
Ft. from S. Line  
990 Ft. from E. Line  
Ft. from W. Line

	0		

Location

Rig up

Drilling and Remarks:

Ady Sha 1879-82

100/50 Bls.

**RECORD**

Cased in. ft.

Sand 1882-1919

Gas

Oil

Total Depth 1940

**PRODUCTION**

1st 24 hrs. Nat.

1st 24 hrs. after shot

Gas Cu. Ft.

Dry Hole

Abandoned

Date

MAR 5 1930

**CHAS. L. SHERWOOD**

192

Scout