


Greenwood

Form 51-5M-5-34-Palace

Map No. KANSAS Sec. 34 Twp. 22 R. 11E

Well No. #5 Harlan Farm
Henderson & Holten Company

NORTH

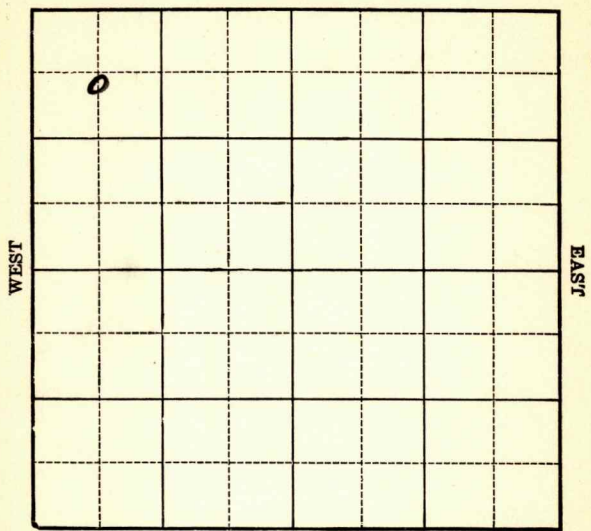

SOUTH

Location _____

Drilling Remarks _____

Rig Up _____

Drilling Remarks _____

RECORD

Cased _____ in. _____ ft.

Sand _____

Gas _____

Oil _____

Total Depth _____

PRODUCTION

1st 24 hrs. Nat. _____

1st 24 hrs. after shot _____

Gas _____ cu. ft.

Dry Hole _____


Abandoned _____

Greenwood

Map No. **KANSAS** Sec. *34* Twp. *22* R. *11E*

Well No. *5* *Harlem* Farm
Henderson & Holden Company

785 Ft. from N. Line
____ Ft. from S. Line
____ Ft. from E. Line
660 Ft. from W. Line

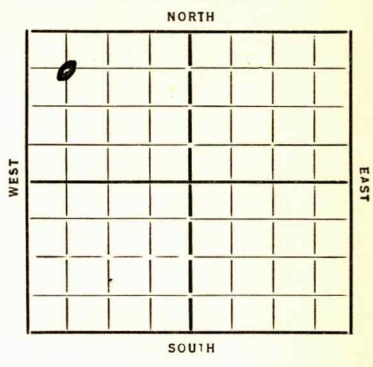

Date *1934*

REPORT

<i>12/19</i>	<i>dlg 725</i>
<i>12/27</i>	<i>" 1290</i>
<i>1/3/35</i>	<i>" 1857</i>
<i>1/9</i>	<i>Sand 1860-71 Sand 1928-60</i>
	<i>T 17 1967 200 pts 20 Blk.</i>

COMPLETED

Greenwood
Map No. 21 Sec. 34 Twp. 22 R. 11E

Well No. 45 Harlan
Henderson & Holden Company

Contractor

FIRST REPORTS

SECTION PLAT

785 Ft. from N. Line
Ft. from S. Line
Ft. from E. Line
660 Ft. from W. Line

0			

Location.....
Rig up.....
Drilling and Remarks:

July 725

RECORD

Cased..... in.,
Sand.....
Gas.....
Oil.....
Total Depth.....

PRODUCTION

1st 24 hrs. Nat.....
1st 24 hrs. after shot.....
Gas..... Cu. Ft.
Dry Hole.....
Abandoned.....

Date 12-19-34 192..... Scout

ORVAL MANNSCHRECK

Map No. 21 Sec. 34 Twp. 22 R. 11E
Well No. 5-Harlan

Henderson + Holden Company

Contractor

COMPLETED

SECTION PLAT

785 Ft. from N. Line
..... Ft. from S. Line
..... Ft. from E. Line
660 Ft. from W. Line

0			

Location.....

Rig up.....

Drilling and Remarks:

200 gts

20 lbs

RECORD

Cased..... in., ft.

Sand 1860-71

Gas sent 1928-60

Oil.....

Total Depth 1967

PRODUCTION

1st 24 hrs. Nat.....

1st 24 hrs. after shot.....

Gas..... Cu. Ft.

Dry Hole.....

Abandoned.....

Date

1-9-35 192.....

ORVAL MANNSCHRECK

Scout

Already have #4 lamp will on
this line - #5?

~~advice~~
Sam

Sam:

This was reported as #4; However,
I checked it with Mr. Henderson
and he advises that it should
be #5.

Oval

~~Handwritten scribbles and lines~~

Returned	RT RT
Cards	ms
Tracing	ms
France Map	ms
Scarborough	ms
Moody Map	ms
Scarborough Plat Book	ms
Moody Plat Book	ms

June 2

1871-2