


Section 34 Township 22 Range 11-E

Well No. #9 Harlan

Company Skelly
Miscellaneous

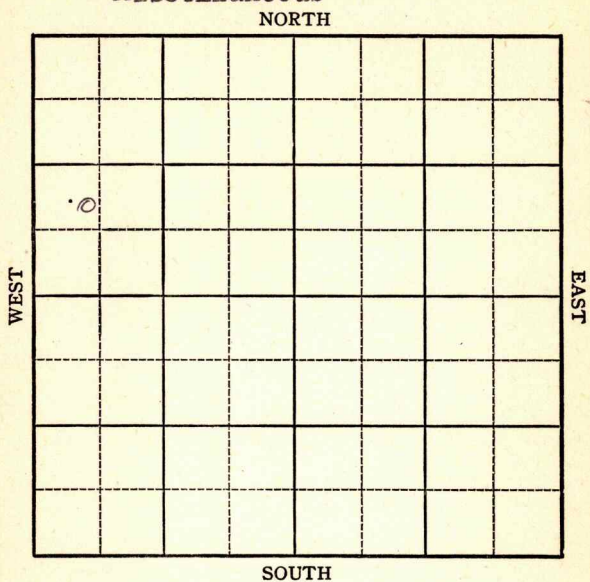

Sec. 34 Twp. R.

Well No. #9 Harlan Farm

Skelly Company

Jackman & Jackman Contractor

Miscellaneous


 Ft. from N. Line

840' Ft. from S. Line

 Ft. from E. Line

640' Ft. from W. Line

C N L SW NW

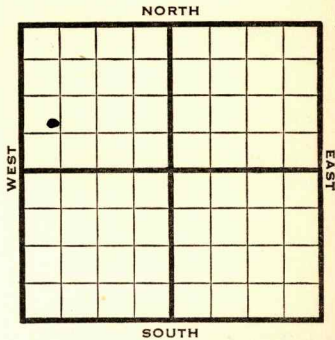

1949 **Elev. 1224'** REPORT

- 11/9 8" @ 63'
Lans. 1205'
KC 1273'
Bart 1855'
TD 1945'
- 11/16 5" @ 1857'
65 qts 1861-1927'
CO
- 11/23 "
- 11/29 60 qts 1866-1907
CO
- 12/7 "
- 12/14 **Bart 1855'**
5" @ 1857'
65 qts
Pump 4 oil & 8 W Pot.
Gr. 38°
TD 1947'

COMPLETED

Kansas

Map No. _____ Sec. 34 Twp. 22 R. 11E

Well No. 9 Harlan

Skelly Company

Jackman & Jackman Contractor

C N L SW NW

FIRST REPORT
SECTION PLAT

_____ Ft. from N. Line

840 Ft. from S. Line

_____ Ft. from E. Line

640 Ft. from W. Line

o			

Greenwood County

Location _____

Rig up _____

Drilling and Remarks:

8" @ 63

Lans. 1205

KC 1273

Bart. 1855

TD 1945

5" @ 1857

RECORD

Cased _____ in., _____ ft.

Sand _____

Gas _____

Oil _____

Total Depth _____

PRODUCTION

1st 24 hrs. Nat. _____

1st 24 hrs. after shot _____

Gas _____ Cu. Ft.

Dry Hole _____

Abandoned _____

Date

NOV 9 1949

19

S. J. LEWIS

Scout

Kansas

Map No. _____ Sec. 34 Twp. 22 R. 11E

Well No. 9 Harlan

Skelly _____ Company

COMPLETE

Contractor

C N L SW NW

E11224

SECTION PLAT

_____ Ft. from N. Line

840 Ft. from S. Line

_____ Ft. from E. Line

640 Ft. from W. Line

0			

Greenwood County

Location _____

Rig up _____

Drilling and Remarks:

Bar 1835
5" @ 1837
659 to
Comp 4 oil + 8 W
CS

RECORD

Cased _____ in., _____ ft.

Sand _____

Gas _____

Oil _____

Total Depth 1947

PRODUCTION

1st 24 hrs. Nat. _____

1st 24 hrs. after shot _____

Gas _____ Cu. Ft.

Dry Hole _____

Abandoned _____

Date

DEC 14 1949

19

S. J. LEWIS Scout