


Map No. _____ Sec. 34 Twp. 22 R. 10

Well No. 1 Barnard Farm _____
Rhodes & Able Company _____

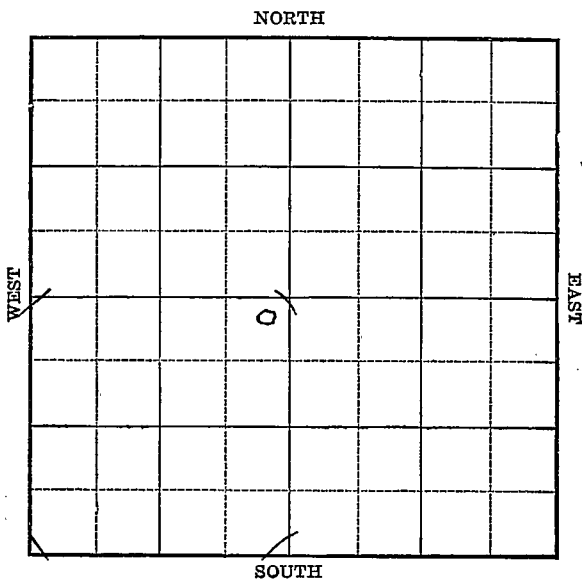

//

Location _____

Rig up _____

Drilling Remarks:

Drilling Remarks:

RECORD

PRODUCTION

Cased _____ in. _____ ft.

1st 24 hrs Nat. _____

Sand _____

1st 24 hrs. after shot _____

Gas _____

Gas _____ cu. ft.

Oil _____

Dry Hole _____

Total Depth _____

Abandoned _____

Map No. *21 Kans* Sec. *34* Twp. *22* R. *10*

Well No. *11 Diamond*

Phelps & Bell Company

Contractor

First Report

SECTION PLAT

200 Ft. from N. Line

_____ Ft. from S. Line

200 Ft. from E. Line

200 Ft. from W. Line

<i>/</i>	<i>0</i>		
<i>/</i>		<i>/</i>	

Location _____

Rig up _____

Drilling and Remarks:

Rig up.

RECORD

Cased _____ in., _____ ft.

Sand _____

Gas _____

Oil _____

Total Depth _____

PRODUCTION

1st 24 hrs. Nat. _____

1st 24 hrs. after shot _____

Gas _____ Cu. Ft.

Dry Hole _____

Abandoned _____

Date

8/4 192*3*

MAD Scout

Map No. *Kans²¹* Sec. *34* Twp. *22* R. *10*

Well No. *1* *Tanner*
Rhodes & Bell Company

Contractor

ABANDONED

SECTION PLAT

200' Ft. from N. Line
 _____ Ft. from S. Line
200' Ft. from E. Line
 _____ Ft. from W. Line

	0		

Location _____

Rig up _____

Drilling and Remarks:

L.O. & O.
2276'

RECORD

Cased _____ in., _____ ft.
 Sand _____
 Gas _____
 Oil _____
 Total Depth _____

PRODUCTION

1st 24 hrs. Nat. _____
 1st 24 hrs. after shot _____
 Gas _____ Cu. Ft.
 Dry Hole _____
 Abandoned _____

Date *M.A.B.* 192

7/23/24 Scout