

Greenwood

Map No. **KANSAS** Sec. *34* Twp. *22* R. *11E*


Well No. *4-Hess* Farm _____
Henderson & Holden Company

_____ Ft. from N. Line

660 Ft. from S. Line

660 Ft. from E. Line

_____ Ft. from W. Line

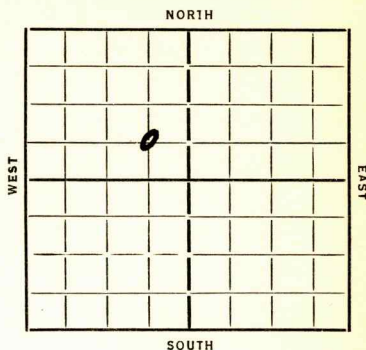

Date
1935
8/28

REPORT

Sand 1877-1925
Oil 1877-87
T 7 1930
170 gts / 75 Bbls.

FIRST REPORT

COMPLETED

Wood

KANSAS

Map No. 21 Sec. 34 Twp. 22 R. 11 E

Well No. 4-Hess

Henderson + Holden Company

Contractor

FIRST REPORTS



COMPLETED

SECTION PLAT

	0		

Ft. from N. Line

660

Ft. from S. Line

660

Ft. from E. Line

Ft. from W. Line

RECORD

Cased.....in.,ft.
 Sand 1877-1925
 Gas.....
 Oil 1877-87
 Total Depth 1930

PRODUCTION

1st 24 hrs. Nat.....
 1st 24 hrs. after shot.....
 Gas.....Cu. Ft.
 Dry Hole.....
 Abandoned.....

Location.....

Rig up.....

Drilling and Remarks:

170 pts
75 bbls

Date

8-28-35 192.....

ORVAL MANNSCHRECK

Scout