


Section 34 Township 22 Range 11E

Well No. #2 Hess

Company Pat Murphy

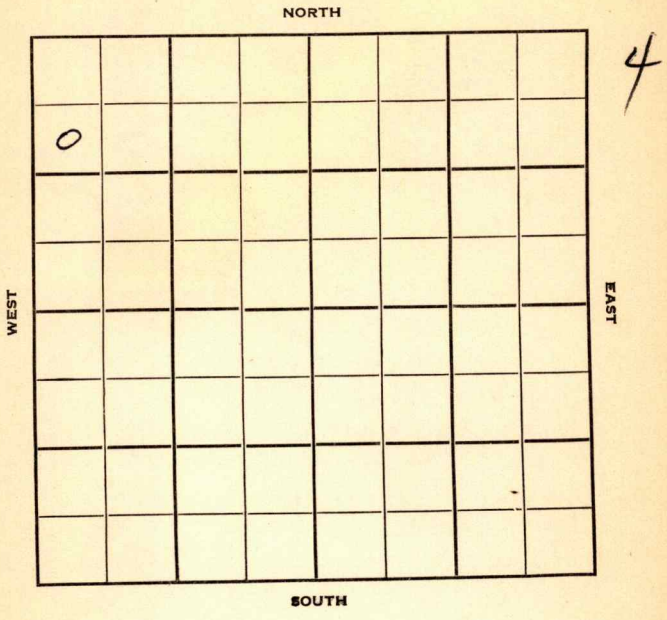

Sec. 34 Twp. 22 R. 11E

Well No. #2 Hess Farm

Pat Murphy Company

Contractor

Miscellaneous


990' Ft. from N. Line

\_\_\_\_\_ Ft. from S. Line

\_\_\_\_\_ Ft. from E. Line

330' Ft. from W. Line

SW NW NW

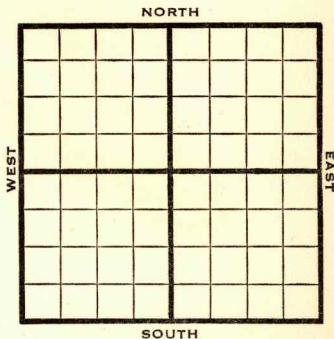

1950

REPORT

4/26

8" @ 46'  
 Bart 1865-66 TD  
 5" @ 1865'  
 DD to 1885 TD  
 40/1870-85  
 Comp. 8 BOPD

**FIRST REPORT  
 &  
 COMPLETED**

Map No. \_\_\_\_\_ Sec. 34 Twp. 22 R. 11E

Well No. 2 Hess

Pat Murphy Company

Contractor

SW NW NW

SECTION PLAT

990 Ft. from N. Line

\_\_\_\_\_ Ft. from S. Line

\_\_\_\_\_ Ft. from E. Line

330 Ft. from W. Line



Greenwood County

Location \_\_\_\_\_

Rig up \_\_\_\_\_

Drilling and Remarks:

8 " @ 46  
 Bart. 1865-66 TD  
 5" @ 1865  
 DD to 1885 TD  
 40/ 1870-85  
 Comp. 8 bopd

RECORD

Cased \_\_\_\_\_ in., \_\_\_\_\_ ft.  
 Sand \_\_\_\_\_  
 Gas \_\_\_\_\_  
 Oil \_\_\_\_\_  
 Total Depth \_\_\_\_\_

PRODUCTION

1st 24 hrs. Nat. \_\_\_\_\_  
 1st 24 hrs. after shot \_\_\_\_\_  
 Gas \_\_\_\_\_ Cu. Ft.  
 Dry Hole \_\_\_\_\_  
 Abandoned \_\_\_\_\_

Date

APR 26 1950 19

J. E. TYRA Scout