


KAN. CAS

Greenwood

Section 34 Township 22 Range 11E

Well No. 5 Hess

Company Skelly
Misc.

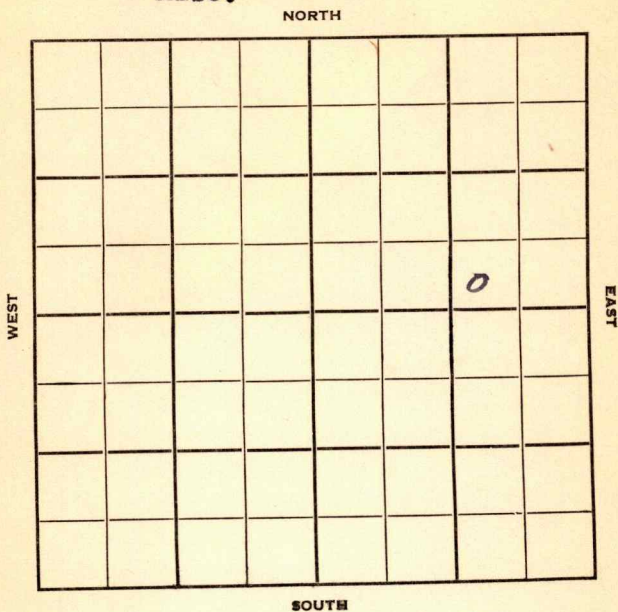

KANSAS Greenwood

Sec. 34 Twp. 22 R. 11E

Well No. #5 Hess Farm

Skelly

Miscellaneous (Jackman & Jackman, Cont.) Company


NORTH

_____ Ft. from N. Line

330' Ft. from S. Line

990' Ft. from E. Line

_____ Ft. from W. Line

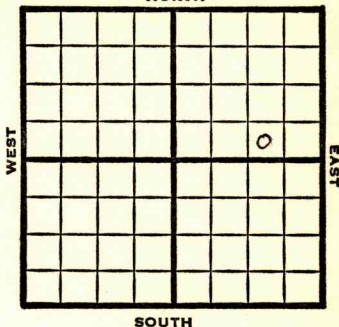

SW SE NE

SOUTH

1949 **Elev.** REPORT

8/10 8" @ 106'

8/17 "

8/24 **Bart. 1874'**

5" @ 1876'

TD 1914'

74 qts 1882-1914. CO

8/31 "

9/7 **Bart 1874'**

5" @ 1876'

74 qts

Pump 52 oil & 90 W Pot.

Gr. 38°

TD 1914'

COMPLETED

Kansas

Map No. _____ Sec. 34 Twp. 22 R. 11E

Well No. 5 Hess

Skelly

Company

Jackman & Jackman

Contractor

SW SE NE

**FIRST REPORT
SECTION PLAT**

_____ Ft. from N. Line

330 Ft. from S. Line

990 Ft. from E. Line

_____ Ft. from W. Line

Greenwood County

RECORD

Location _____

Cased _____ in., _____ ft.

Rig up _____

Sand _____

Drilling and Remarks:

Gas _____

8" @ 106

Oil _____

Total Depth _____

PRODUCTION

1st 24 hrs. Nat. _____

1st 24 hrs. after shot _____

Gas _____ Cu. Ft.

Dry Hole _____

Abandoned _____

Date

AUG 10 1949 19

S. J. LEWIS Scout

Map No. 1521 Sec. 34 Twp. 22 R. 11E

Well No. 5 Hess

Skelly Company

COMPLETE Contractor

SW SE NE

SECTION PLAT

			0

_____ Ft. from N. Line

330 Ft. from S. Line

990 Ft. from E. Line

_____ Ft. from W. Line

Greenwood County

Location _____

Rig up _____

Drilling and Remarks:

Bo 8/1874
5" C 1876
249 1/2
Pump 52 oil + 90 N
OK
38 3/4

RECORD

Cased _____ in., _____ ft.

Sand _____

Gas _____

Oil _____

Total Depth 1914

PRODUCTION

1st 24 hrs. Nat. _____

1st 24 hrs. after shot _____

Gas _____ Cu. Ft.

Dry Hole _____

Abandoned _____

Date

SEP 7 1949 19

S. J. LEWIS Scout