


Map No. KANSAS Sec. 35 Twp. 22^S R. 3^E

Well No. 1-Launch Farm
Solburn & Mitchell Company

NORTH

WEST

EAST

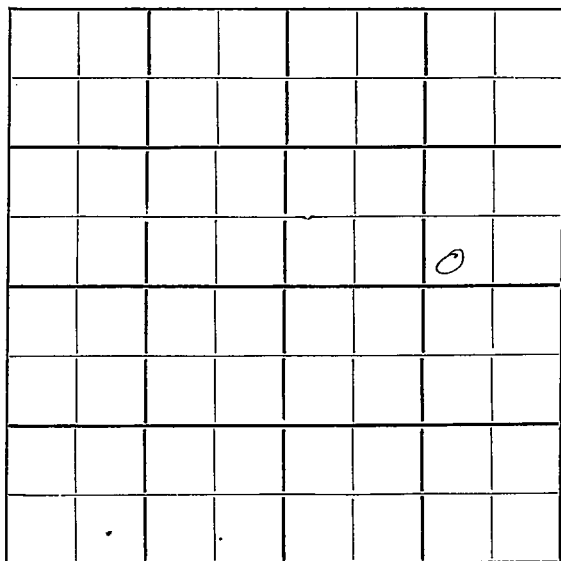

SOUTH

Location.....

Drilling Remarks

Rig Up.....

Drilling Remarks

RECORD

Cased.....in.....ft.

Sand.....

Gas.....

Oil.....

Total Depth.....

PRODUCTION

1st 24 hrs. Nat.....

1st 24 hrs. after shot.....

Gas.....cu. ft.....

Dry Hole.....

Abandoned.....

Map No. Sec. Twp. R.

Well No. Farm


..... Company

..... Ft. from N. Line

..... Ft. from S. Line

..... Ft. from E. Line

..... Ft. from W. Line

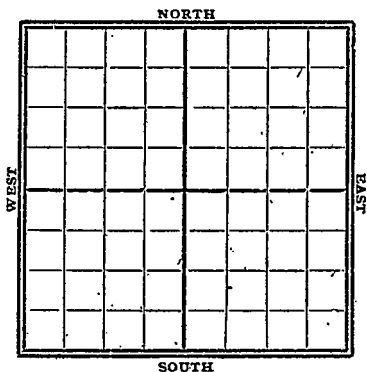

1922

Date

REPORT

Gypsy Records

7/5

Abd T.D. 2812'

K24 KANSAS SEC. 35 TWP. 27S R. 3E
MAP NO.

WELL No. 1 Rank

Delburn & Mithel COMPANY

CONTRACTOR

Mathias
file
ABANDONED

SECTION PLAT

			0

_____ FT. FROM N. LINE

_____ FT. FROM S. LINE

_____ FT. FROM E. LINE

_____ FT. FROM W. LINE

No Record

RECORD

LOCATION _____

CASED _____ IN. _____ FT.

RIG UP _____

SAND _____

DRILLING AND REMARKS

GAS _____

OIL _____

TOTAL DEPTH 2812

PRODUCTION

1ST 24 HRS. NAT. _____

1ST 24 HRS. AFTER SHOT _____

GAS _____ CU. FT.

DRY HOLE ☒

ABANDONED ☒

DATE

7/5 1922

SCOUT

Coal marked
with T.D.
Called 2812
Company man
1st Park
left off
Completely
checked