


NORTH

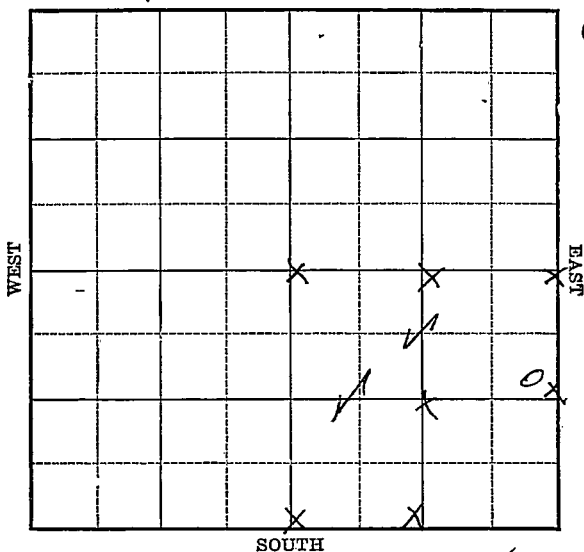

Drilling Remarks

Drilling Remarks

RECORD

Cased _____ in. _____ ft.

Sand

Gas

Oil

Total Depth_____

PRODUCTION

1st 24 hrs. Nat.

1st. 24 hrs. after shot_____

Gas_____cu. ft.

Dry Hole_____

Abandoned


Map No. ~~4400~~ Sec. 35 Twp. 22 R. 9
 Well No. 5-Nartley Farm
Delby O & H. Company

990 Ft. from N. Line

_____ Ft. from S. Line

330 Ft. from E. Line

_____ Ft. from W. Line

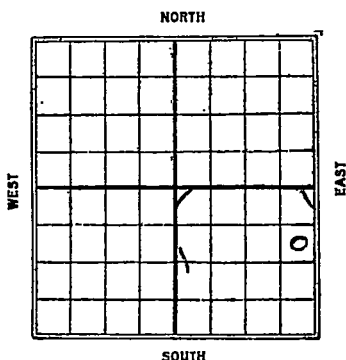

1925

Date

REPORT

8/7 Location

8/14 _____

8/19 _____

8/26 _____

9/3 Rig

9/11 _____

9/16 _____

9/24 _____

10/1 Same

10/8 _____

10/16 spud

10/22 Lrlg @ 600'

10/29 ✓ ✓ 1416'

11/27 Sand 2537-2579

15 Bbls mah

Map No. 22 Shabo Sec. 35 Twp. 22 R. 9

Well No. 5 Hutton

Belby Oil & Gas Co Company

Contractor

FIRST REPORTS


SECTION PLAT

990 Ft. from N. Line

_____ Ft. from S. Line

330 Ft. from E. Line

_____ Ft. from W. Line

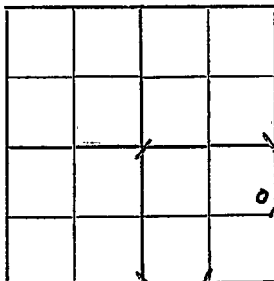

Location ☒

Rig up _____

Drilling and Remarks:

RECORD

Cased _____ in., _____ ft.

Sand _____

Gas _____

Oil _____

Total Depth _____

PRODUCTION

1st 24 hrs. Nat. _____

1st 24 hrs. after shot _____

Gas _____ Cu. Ft.

Dry Hole _____

Abandoned _____

Date

AUG 7 1925

CHAS. L. SHERWOOD

192

Scout

✓✓✓ Map No. **KANSAS** Sec. **35** Twp. **22** R. **9**

Well No. **5 Hartley**

Alley Oil & Gas Co Company

Contractor

COMPLETED


SECTION PLAT

990 Ft. from N. Line

Ft. from S. Line

330 Ft. from E. Line

Ft. from W. Line

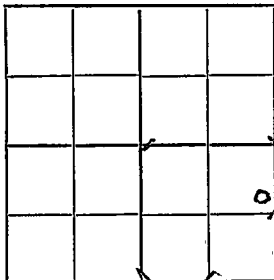

Location

Rig up

Drilling and Remarks:

Pay 2537-46'

15 bhs Natural

RECORD

Cased in. ft.

Sand **2537-2579'**

Gas

Oil

Total Depth **2579'**

PRODUCTION

1st 24 hrs. Nat.

1st 24 hrs. after shot

Gas Cu. Ft.

Dry Hole

Abandoned

Date

NOV 27 1925

CHAS. L. SHERWOOD

192

Scout