


Map No. 1 Kansas Sec. 35 Twp. 22 R. 9Well No. 6 Hartley FarmSelby O. & G. Company

NORTH

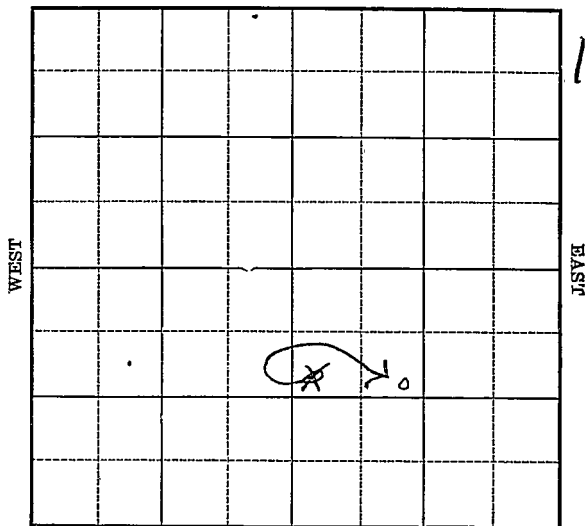

SOUTH

Location _____

Drilling Remarks _____

Rig Up _____

Drilling Remarks _____

RECORD

Cased _____ in. _____ ft.

Sand _____

Gas _____

Oil _____

Total Depth _____

PRODUCTION

1st 24 hrs. Nat. _____

1st 24 hrs. after shot _____

Gas _____ cu. ft.


Dry Hole _____

Abandoned _____

Chase Co

Map No. 1 Kansas Sec. 35 Twp. 22 R. 9Well No. 6 Hartley FarmSelby O. & G. Company

NORTH

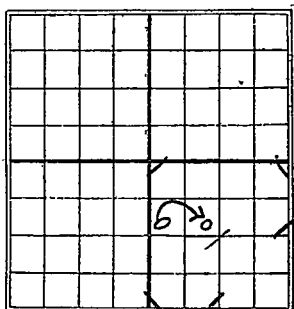990 Ft. from N. Line.

_____ Ft. from S. Line

_____ Ft. from E. Line

990
220 Ft. from W. Line

SOUTH

Date 1925 REPORT

<u>11/27</u>	<u>Bldg Rig</u>
<u>12/3</u>	<u>Rig</u>
<u>12/10</u>	<u>—</u>
<u>12/17</u>	<u>Spudding</u>
<u>12/23</u>	<u>—</u>
<u>12/31</u>	<u>Running 10" 1160'</u>
<u>1926</u>	
<u>1/8</u>	<u>Drlg 1400'</u>
<u>1/14</u>	<u>—</u>
<u>1/20</u>	<u>small show 2461-691</u>
<u>1/27</u>	<u>top line 2623' Drlg 2730'</u>
<u>2/3</u>	<u>S.D. 2759'</u>
	<u>Abandoned 2759'</u>

K 22 KANSAS

Map No. _____ Sec. 35 Twp. 22 R. 9

Well No. 6

Huntby
Kelby Oil & Gas Co. Company

Contractor _____


SECTION PLAT

990 Ft. from N. Line

_____ Ft. from S. Line

_____ Ft. from E. Line

330 Ft. from W. Line

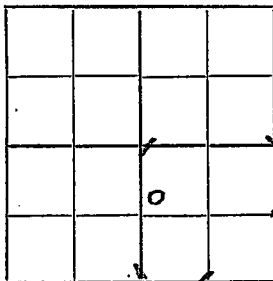

FIRST REPORTS

Location _____

Rig up _____

Drilling and Remarks:

Blow Rig

RECORD

Cased _____ in., _____ ft.

Sand _____

Gas _____

Oil _____

Total Depth _____

PRODUCTION

1st 24 hrs. Nat. _____

1st 24 hrs. after shot _____

Gas _____ Cu. Ft.

Dry Hole _____

Abandoned _____

Date

NOV 27 1925

CHAS. L. SHERWOOD

192

Scout


Map No. **KANSAS** Sec. **23 35** Twp. **22** R. **9**

Well No. **6** **Hartley**

Holley Oil & Gas Co Company

Contractor

SECTION PLAT

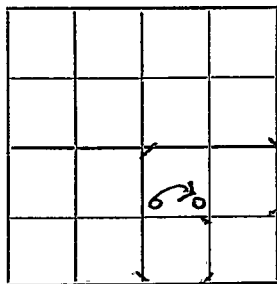

990

Ft. from N. Line

Ft. from S. Line

Ft. from E. Line

990

Ft. from W. Line

CORRECTION

Location ☒

Rig up ☒

Drilling and Remarks:

chg location to above.

RECORD

Cased _____ in., _____ ft.

Sand _____

Gas _____

Oil _____

Total Depth _____

PRODUCTION

1st 24 hrs. Nat. _____

1st 24 hrs. after shot _____

Gas _____ Cu. Ft.

Dry Hole _____

Abandoned _____

Date

DEC 3 1925

CHAS. L. SHERWOOD

192

Scout

22 KANSAS 35 Chase Co
 Map No. Sec. Twp. R. 9

Well No. 6 Hartley
 Helby oil & Gas Co Company

Contractor

COMPLETED

SECTION PLAT


990 Ft. from N. Line

Ft. from S. Line

Ft. from E. Line

990 Ft. from W. Line

ABANDONED

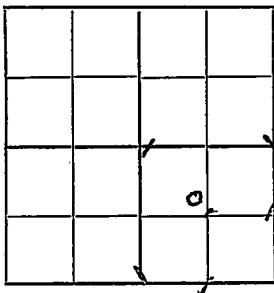

Location

Rig up

Drilling and Remarks:

Show oil 2464 69'

Top line 2623'

Dry & whd

27 2759'

RECORD

Cased in., ft.

Sand

Gas

Oil

Total Depth 2759'

PRODUCTION

1st 24 hrs. Nat.

1st 24 hrs. after shot

Gas Cu. Ft.

Dry Hole ✓

Abandoned ✓

Date

FEB 3 1926

CHAS. L. SHERWOOD

192

Scout