

Sec. 35 Twp. 22 R. 9^E

Twp.

R.

Farm

Company

NORTH

WEST

EAST

SOUTH

Location _____

Drilling Remarks

Rig Up _____

Drilling Remarks

RECORD

Cased_____in._____ft.

Sand _____

Gas _____

Oil _____

Total Depth_____

PRODUCTION

1st 24 hrs. Nat. _____

1st 24 hrs. after shot_____

Gas _____ cu. ft. _____

Dry Hole_____

Abandoned _____


Shase
Map No. KANSAS Sec. 35 Twp. 22 R. 1
Well No. 2 Leidy Farm
Seiby O & I Company

 Ft. from N. Line

990 Ft. from S. Line

330 Ft. from E. Line

 Ft. from W. Line

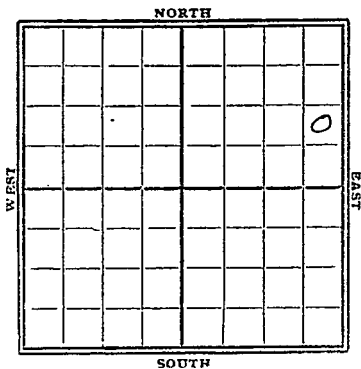

1929

Date REPORT

7/31 Reig
8/17 Leidy
8/14 Drly 1099'
8/21 " 1465
8/28 " 2000
9/3 sand 2446-73'
small show - drly.
9/11 sand 2446-73'
T.D. 2482'
shot 18 qt
10 bbl oil
Comp.

1822 *Chase*
 Map No. **KANSAS** Sec. *35* Twp. *22* R. *9* ^E
 Well No. *2* *Leedy*
Selby Oil & Gas Co Company
J Contractor

FIRST REPORTS

SECTION PLAT

			o

_____ Ft. from N. Line

990 Ft. from S. Line

330 Ft. from E. Line

_____ Ft. from W. Line

Location _____

Rig up ☒

Drilling and Remarks:

RECORD

Cased _____ in., _____ ft.

Sand _____

Gas _____

Oil _____

Total Depth _____

PRODUCTION

1st 24 hrs. Nat. _____

1st 24 hrs. after shot _____

Gas _____ Cu. Ft.

Dry Hole _____

Abandoned _____

Date
JUL 31 1929

CHAS. L. SHERWOOD

Chase

22 **KANSAS** Sec. 35 Twp. 22 R. 9

Well No. 2 Leeder
Selby Drilling

Company

Contractor

COMPLETE

SECTION PLAT

			0

_____ Ft. from N. Line

990 Ft. from S. Line

330 Ft. from E. Line

_____ Ft. from W. Line

Location _____

Rig up _____

Drilling and Remarks:

18/10 Bbs.

RECORD

Cased _____ in., _____ ft.

Sand 7446-7473

Gas _____

Oil _____

Total Depth 7482

PRODUCTION

1st 24 hrs. Nat. _____

1st 24 hrs. after shot _____

Gas _____ Cu. Ft.

Dry Hole _____

Abandoned _____

Date

SEP 11 1929

CHAS. L. SHERWOOD