

Map No. Kans Sec. 36 Twp. 22 R. 9
Well No. 5 Hartley Farm
Mid-Kansas Company
NORTH

NORTH

A 10x10 grid with 'WEST' on the left and 'EAST' on the right. A small circle is in the 5th row, 1st column.

SOUTH

Location _____

Drilling Remarks

Rig Up_____

Drilling Remarks

RECORD

Cased_____in. _____ft.

Sand

Gas

Oil

Total Depth _____

PRODUCTION

1st 24 hrs. Nat. _____

1st 24 hrs. after shot_____

Gas _____ cu. ft.

Dry Hole _____

Abandoned

Chase

Map No. MAN Sec. 36 Twp. 22 R. 9Well No. 5 Hartly Farm
Mid-Kansas Company

NORTH


990 Ft. from N. Line

_____ Ft. from S. Line

_____ Ft. from E. Line

330 Ft. from W. Line

WEST

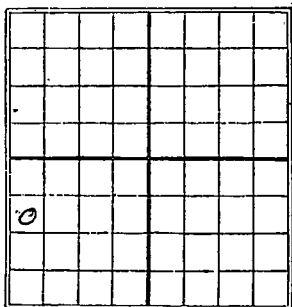

EAST

SOUTH

1926

Date

REPORT

8/4 P. O. G.8/11 Abnd location

22 **KANSAS** Sec. 36 Twp. 22 R. 9
 Map No. _____
 Well No. 5 Hartley
 Mid-Kan Co. _____ Company
 _____ Contractor


FIRST REPORTS**SECTION PLAT**

990 Ft. from N. Line

_____ Ft. from S. Line

_____ Ft. from E. Line

330 Ft. from W. Line

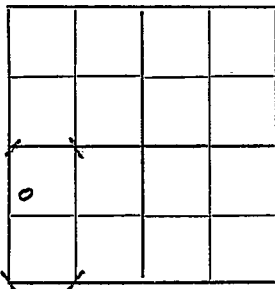

Location _____

Rig up _____

Drilling and Remarks:

168

RECORD

Cased _____ in., _____ ft.

Sand _____

Gas _____

Oil _____

Total Depth _____

PRODUCTION

1st 24 hrs. Nat. _____

1st 24 hrs. after shot _____

Gas _____ Cu. Ft.

Dry Hole _____

Abandoned _____

Date 4 1926
AUG

192 CHAS. L. SHERWOOD
 _____ Scout

Chase
 22 KANSAS 36
 Map No. _____ Sec. _____ Twp. 22 R. 9
 Well No. 5 Hartley
 Mid-Kansas
 _____ Company
 _____ Contractor

COMPLETED

990 Ft. from N. Line

_____ Ft. from S. Line

_____ Ft. from E. Line

330 Ft. from W. Line

ABANDONED

SECTION PLAT

6			

Location _____

Rig up _____

Drilling and Remarks: _____

RECORD

Cased _____ in., _____ ft.

Sand _____

Gas _____

Oil _____

Total Depth _____

PRODUCTION

1st 24 hrs. Nat. _____

1st 24 hrs. after shot _____

Gas _____ Cu. Ft.

Dry Hole _____

Abandoned location

Date

AUG 11 1926

CHAS. L. SHERWOOD

192

Scout