

Map No. **KANSAS** Sec. 36 Twp. 22 R. 9^E

Well No. 5 - Leedy Farm

Smith & Polkman Company


_____ Ft. from N. Line

330 Ft. from S. Line

_____ Ft. from E. Line

940 Ft. from W. Line

1932

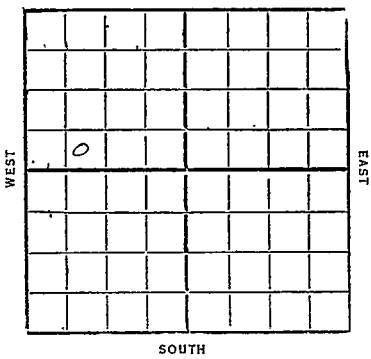

Date

REPORT

5/14

10"-1290
Drlg 1700'

5/11

" 2220'

5/18

5"-2400'
Top sand 2439
drlg 2451 sand
Est 25 bbl oil

5/25

6/11

6/8

No report
Sand 2426-78
TD 2478
Shot 80 qt
100. bbl oil
Comp.

Chase

22 KANSAS

Map No. _____ Sec. *36* Twp. *22* R. *9*

Well No. *5* *Leedy*

Smith & Pelham Company

Contractor

FIRST REPORTS

SECTION PLAT

_____ Ft. from N. Line

330 Ft. from S. Line

_____ Ft. from E. Line

990 Ft. from W. Line

Location _____

Rig up _____

Drilling and Remarks: _____

10" 1290
dry 1700'

RECORD

Cased _____ in., _____ ft.

Sand _____

Gas _____

Oil _____

Total Depth _____

PRODUCTION

1st 24 hrs. Nat. _____

1st 24 hrs. after shot _____

Gas _____ Cu. Ft.

Dry Hole _____

Abandoned _____

Date

MAY 4 1932 CHAS. L. SHERWOOD

192

Scout

Chase

22 Map No. **KANSAS** Sec. *36* Twp. *22* R. *9* ^{E.}

Well No. *5* *Reedy*

Smith & Palhamus Company

Contractor

COMPLETED

SECTION PLAT

..... Ft. from N. Line

330 Ft. from S. Line

..... Ft. from E. Line

990 Ft. from W. Line

<i>0</i>			

Location.....

Rig up.....

Drilling and Remarks: -

Shot 801
100 Bbs.

RECORD

Cased..... in., ft.

Sand *2476-2478*

Gas.....

Oil.....

Total Depth *2478*

PRODUCTION

1st 24 hrs. Nat.....

1st 24 hrs. after shot.....

Gas..... Cu. Ft.

Dry Hole.....

Abandoned.....

Date

JUN 8 1932

CHAS. L. SHERWOOD

.....192..... Scout