
Form 51—5M—7-25—19786

Map No. Kansas Sec. 36 Twp. 22 R. 9 E

Well No. 3- Hartley Farm

Mid-Kansas Company

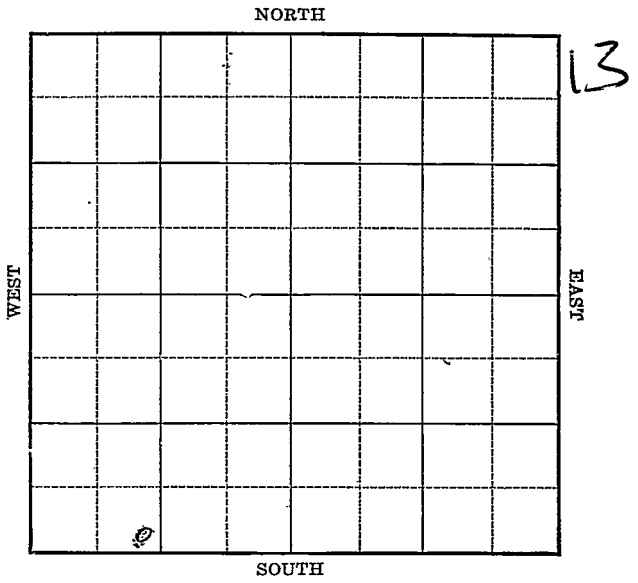

Location

Drilling Remarks

Rig Up

Drilling Remarks

RECORD

Cased in. ft.

Sand

Gas

Oil

Total Depth

PRODUCTION

1st 24 hrs. Nat.

1st 24 hrs. after shot

Gas cu. ft.

Dry Hole

Abandoned

Form 252A—5M—7-25—19684

Chase


Map No. Kansas Sec. 36 Twp. 22 R. 9

Well No. 3 Hartley Farm

Mid-Kansas Company

330 Ft. from S. Line

990 Ft. from W. Line

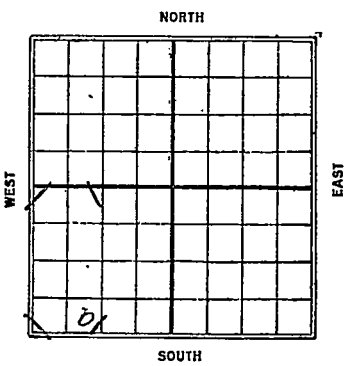

Date 1926	REPORT
4/7	Timbers
4/15	——
4/21	Rig
4/30	Dlg 250
5/8	Dlg 700
5/12	" 800'
5/19	——
6/2	drlg 1400'
6/10	" 1850
6/18	——
6/24	Sand 2441-2483
	60 gts 135 bbls

Form 26—1M Bks.—3-23—11959.

Chase

K22

Map No. KANSAS Sec. 36 Twp. 22 R. 9

Well No. 2 Hartley

Mid-Kansas Company

Contractor

FIRST REPORTS


Ft. from N. Line

330 Ft. from S. Line

Ft. from E. Line

990 Ft. from W. Line

SECTION PLAT

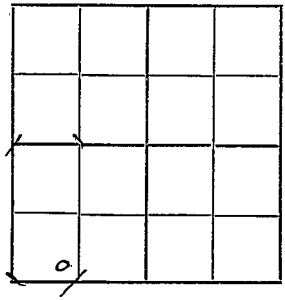

Location

Rig up Jenkins

Drilling and Remarks:

RECORD

Cased in., ft.

Sand

Gas

Oil

Total Depth

PRODUCTION

1st 24 hrs. Nat.

1st 24 hrs. after shot

Gas Cu. Ft.

Dry Hole

Abandoned

Date

APR. 7 1926

192

CHAS. L. SHERWOOD

Scout

Form 26—1M Bks.—3-23—11959. Clark Co.

K22 KANSAS Map No. Sec. 36 Twp. 22 R. 9

Well No. 3 Hartley

Mid-Kansas Oil Co. Company

Contractor

COMPLETED


Ft. from N. Line

330 Ft. from S. Line

Ft. from E. Line

990 Ft. from W. Line

SECTION PLAT

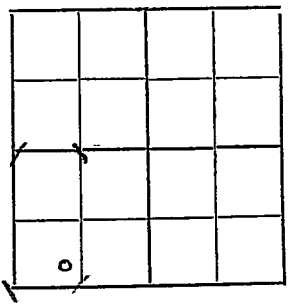

Location

Rig up

Drilling and Remarks:

Ld 135 ft.

RECORD

Cased in., ft.

Sand 2441-2483

Gas

Oil

Total Depth 2483'

PRODUCTION

1st 24 hrs. Nat.

1st 24 hrs. after shot

Gas Cu. Ft.

Dry Hole

Abandoned

Date

JUN 24 1926

192

CHAS. L. SHERWOOD

Scout