


Chase
 Map No. KANSAS Sec. 36 Twp. 22 R. 9E
 Well No. 6-Leedy Farm 1
Polhamus & Smith Company

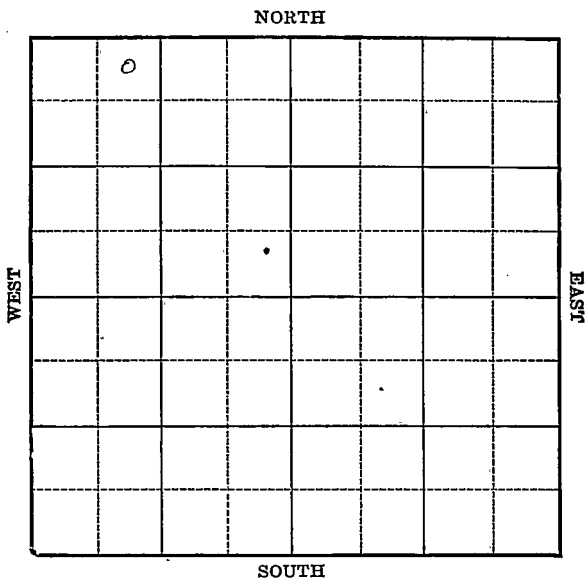

Location _____
 Drilling Remarks _____

Rig Up _____
 Drilling Remarks _____

RECORD

Cased _____ in. _____ ft.
 Sand _____
 Gas _____
 Oil _____
 Total Depth _____

PRODUCTION

1st 24 hrs. Nat. _____
 1st 24 hrs. after shot _____
 Gas _____ cu. ft.
 Dry Hole _____
 Abandoned _____

Map No. KANSAS Sec. 36 Twp 22 R. 9^E

Well No. 6 - Leedy Farm
Polhamus & Smith Company


250 Ft. from N. Line

_____ Ft. from S. Line

_____ Ft. from E. Line

1070 Ft. from W. Line

1932

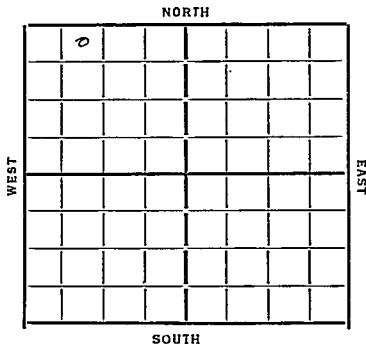

Date

REPORT

12/14 Blkg rig

12/21 Rig

12/28 —

1933 —

1/4 Rgn up

1/11 —

1/18 Drly 600'

1/25 " " 980'

2/11 stg 10"-1620'

2/18 Drly 1965'

2/15 " " 2000'

2/22 stg 6"-2290

3/1 Sand 2465-2500

shot 80 gts

Est 100 bbls

(Comp)

22 KANSAS

Map No. _____ Sec. 36 Twp. 22 R. 9

Well No. 6 Leedy

Polhamus & Smith Company

Contractor

FIRST REPORTS

250 Ft. from N. Line

_____ Ft. from S. Line

_____ Ft. from E. Line

1070 Ft. from W. Line

SECTION PLAT

°			

Location _____

Rig up _____

Drilling and Remarks:

Bleg Rig

RECORD

Cased _____ in., _____ ft.

Sand _____

Gas _____

Oil _____

Total Depth _____

PRODUCTION

1st 24 hrs. Nat. _____

1st 24 hrs. after shot _____

Gas _____ Cu. Ft.

Dry Hole _____

Abandoned _____

Date

DEC 1 - 1932 CHAS. L. SHERWOOD

192

Scout

22 KANSAS

Map No. _____ Sec. 36 Twp. 22 R. 9^E

Well No. 6 Leedy


Contractor

COMPLETED

SECTION PLAT

250 Ft. from N. Line

Ft. from S. Line

Ft. from E. Line

1070 Ft. from W. Line

0			

Location _____

Rig up _____

Drilling and Remarks:

Shot 80/
est 100 Bbs

RECORD

Cased _____ in., _____ ft.

Sand 2465-2500

Gas _____

Oil _____

Total Depth 2500

PRODUCTION

1st 24 hrs. Nat. _____

1st 24 hrs. after shot _____

Gas _____ Cu. Ft.

Dry Hole _____

Abandoned _____

Date

MAR 1

1933

CHAS. L. SHERWOOD

192

Scout