


Chase

FORM 51-5M-6-29-PETROL

Map No. KANSAS Sec. 36 Twp. 22 R. 9^E

Well No. 2 - Leedy Farm
Polhomaust et al Company

NORTH

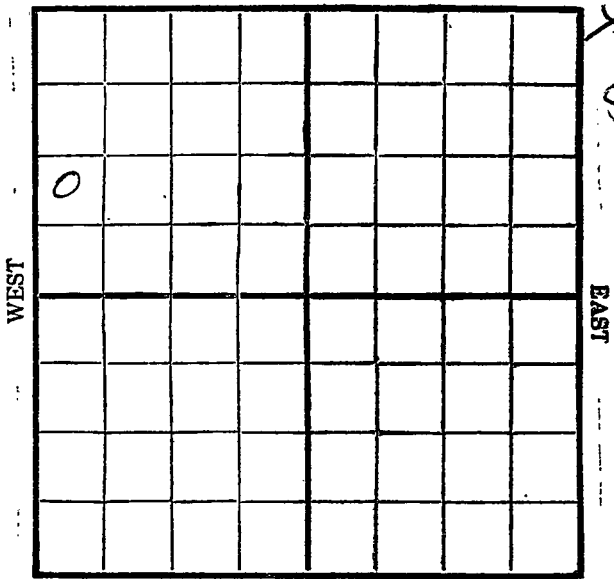

SOUTH

Location _____
 Drilling Remarks _____

Rig Up _____
 Drilling Remarks _____

RECORD

Cased _____ in. _____ ft.
 Sand _____
 Gas _____
 Oil _____
 Total Depth _____

PRODUCTION

1st 24 hrs. Nat. _____
 1st 24 hrs. after shot _____
 Gas _____ cu. ft. _____
 Dry Hole _____
 Abandoned _____

Map No. KANSAS Sec. 36 Twp. 22 R. 9E

Well No. 2 - Leedy Farm
Polhamus et al Company


_____ Ft. from N. Line

990 Ft. from S. Line

_____ Ft. from E. Line

330 Ft. from W. Line

1929

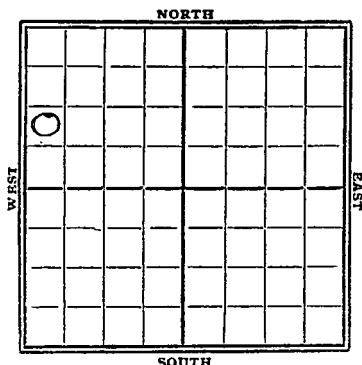

Date

REPORT

Date	REPORT
8/21	Bldg Rig
8/28	Rig
9/14	Run in
9/11	Spdy 1300'
9/18	Wbld 760'
9/25	set 10" - 1350'
10/2	Wbld 1910'
10/19	set 8" - 2025'
10/16	sand 2472 - 76' show oil & water
10/23	sand 2482 - 92 TD. 2537 1/2' shot 60 gts @ 90 bbls oil comp.

Chose

22 KANSAS
Map No. _____ Sec. *36* Twp. *22* R. *9*^E

Well No. *2* *Leedy*

Polhamus Coal Company

Contractor

FIRST REPORTS

SECTION PLAT

_____ Ft. from N. Line

990 Ft. from S. Line

_____ Ft. from E. Line

330 Ft. from W. Line

<i>0</i>			

Location _____

Rig up _____

Drilling and Remarks:

Blky Rig.

RECORD

Cased _____ in., _____ ft.

Sand _____

Gas _____

Oil _____

Total Depth _____

PRODUCTION

1st 24 hrs. Nat. _____

1st 24 hrs. after shot _____

Gas _____ Cu. Ft.

Dry Hole _____

Abandoned _____

Date *8/21* 19*29*

CHAS. L. SHERWOOD

Scout

Chase

Map No. **KANSAS** Sec. **36** Twp. **22** R. **9**

Well No. **22** **Leedy**

Polkomus et al Company

Contractor

COMPLETE

SECTION PLAT

.....Ft. from N. Line

990 Ft. from S. Line

.....Ft. from E. Line

330 Ft. from W. Line

0			

Location.....

Rig up.....

Drilling and Remarks:

60/90 Bls.

RECORD

Cased.....in.,ft.

Sand **7482-7492**

Gas.....

Oil.....

Total Depth **7537 1/2**

PRODUCTION

1st 24 hrs. Nat.....

1st 24 hrs. after shot.....

Gas.....Cu. Ft.

Dry Hole.....

Abandoned.....

Date

OCT 23 1929

192.....

CHAS. L. SHERWOOD

Scout