


Map No. Kans Sec. 36 Twp. 22 R. 12
Well No. Schwab Farm
Spelly Company
NORTH

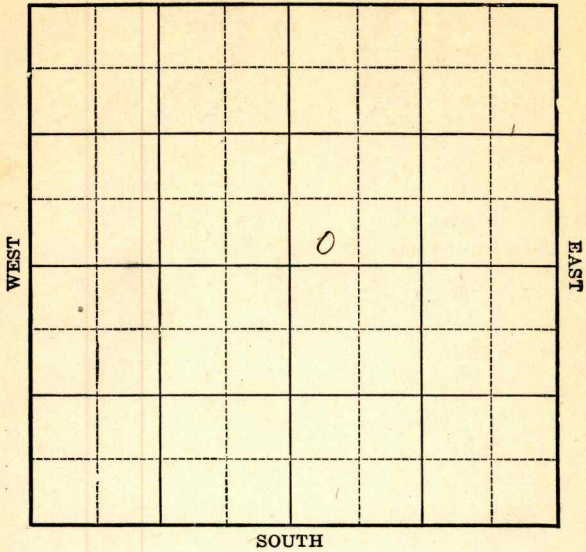

Location _____
Drilling Remarks _____

RECORD

Cased _____ in. _____ ft.
Sand _____
Gas _____
Oil _____
Total Depth _____

Rig Up _____
Drilling Remarks _____

PRODUCTION


1st 24 hrs. Nat. _____
1st. 24 hrs. after shot _____
Gas _____ cu. ft.
Dry Hole _____
Abandoned _____

Map No. Kansas Sec. 36 Twp. 22 R. 12Well No. 1 Schwab FarmStelly Company

_____ Ft. from N. Line

200 Ft. from S. Line

_____ Ft. from E. Line

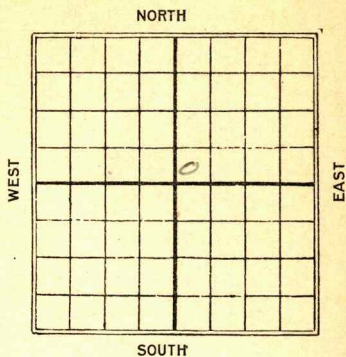200 Ft. from W. Line

Date

REPORT

19253/4 Location5/1 Top 2074 T.D. 2177D. + G. 2177

Map No. *2-1/4 Chas* Sec. *36* Twp. *22* R. *12*Well No. *1* *Schwab**Brilly oil Co* Company

Contractor

COMPLETED

SECTION PLAT

Ft. from N. Line

200 Ft. from S. Line

Ft. from E. Line

200 Ft. from W. Line

ABANDONED

		0	

Location

Rig up

Drilling and Remarks:

dry & khd
to 2177'

RECORD

Cased _____ in., _____ ft.

Sand *2074' No show*

Gas _____

Oil _____

Total Depth *2177'*

PRODUCTION

1st 24 hrs. Nat. _____

1st 24 hrs. after shot _____

Gas _____ Cu. Ft.

Dry Hole ☒Abandoned ☒

Date

MAY 1 1925

192 Scout

CHAS. L. SHERWOOD

21 **KANSAS** Map No. Sec. 36 Twp. 22 R. 12

Well No. 1 Schwab.

Skelly Company

Contractor

FIRST REPORT

SECTION PLAT

_____ Ft. from N. Line

200 _____ Ft. from S. Line

_____ Ft. from E. Line

200 _____ Ft. from W. Line

		o	

Location ✓✓

Rig up

Drilling and Remarks:

RECORD

Cased _____ in., _____ ft.

Sand _____

Gas _____

Oil _____

Total Depth _____

PRODUCTION

1st 24 hrs. Nat. _____

1st 24 hrs. after shot _____

Gas _____ Cu. Ft.

Dry Hole _____

Abandoned _____

Date

3/24 1926

M. A. BENEAR

Scout