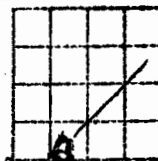


23-22-4E

WELL LOG BUREAU - KANSAS GEOLOGICAL SOCIETY
412 Union National Bk Bldg. Wichita, KansasCompany E. H. ADAIR OIL COMPANY
Farm Jensen "B" No. 1SEC. 23 T. 22 R. 4E
SW SE SWTotal Depth. 2600'
Comm. 12-11-47
Shot or Treated.
Contractor.
Issued. 2-28-48

Comp. 1-6-48

County. Marion
KANSAS

Elevation. 1441

Production. Dry

CASING:

15-1/2" 120' 10" 1735'
13-3/8" 880' 8 1/4" 2295'

Figures Indicate Bottom of Formations.

cellar lime	6	lime	1330
lime	20	shale	1335
clay yellow	45	lime	1365
lime	75	shale	1375
shale	90	lime	1390
red rock	100	shale	1405
shale	105	lime	1420
lime	250	shale	1430
shale	265	lime	1440
red rock	270	shale	1445
lime	295	lime	1450
shale	305	shale	1465
lime	345	lime	1495
shale	355	shale	1535
lime	370	lime	1635
shale	390	shale	1665
lime	400	shale sdy	1725
shale & shells	490	shale	1760
shale	500	lime	1765
red rock	505	shale	1780
lime	530	lime	1795
shale	535	shale	1845
lime	580	lime	2090
shale	610	shale	2100
lime	640	lime	2135
shale	650	shale	2140
shale & shells	700	lime	2165
shale	735	shale	2170
lime	745	lime	2215
shale	775	shale	2265
red rock	780	shale & shells	2290
shale	795	lime	2295
lime	800	shale	2300
shale & shells	845	lime brkn	2330
shale	875	shale	2340
lime	880	lime	2360
shale	910	shale	2365
lime	920	lime	2395
shale	935	shale	2400
lime	945	red rock	2408
shale	955	cherty cong.	2424
lime	965	lime S.O.	2428
shale	975	chert	2445
lime	985	lime	2480
shale	1005	shale	2560
lime	1040	shale blk	2590
shale & shells	1090	shale wh	2595
lime sdy	1105	sand water	2600
shale	1130	Total Depth	
lime	1140		
shale	1170	Water Record:	
lime	1190	4 BWPH	65-75
shale	1210	1 BWPH	575-80
shale sdy	1220	1 1/2 BWPH	1090-1100
shale	1235	1 1/2 BWPH	1210-20
		1 1/2 BWPH	1850-60
		2 RWPH	2310-25

KANSAS

Marion

Sec. 23 Twp. 22 R. 4E

Well No. #1 Jensen "B" Farm

E. Adair

Company

Wildcat


Ft. from N. Line

330 Ft. from S. Line

990 Ft. from E. Line

Ft. from W. Line

SW SE SW

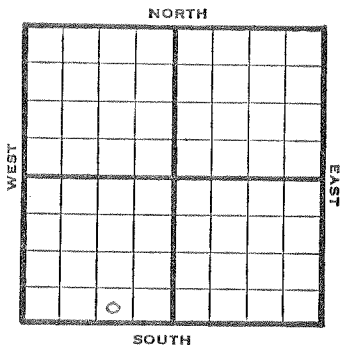

1947 Elev. 1441' REPORT

12/3 Location

12/10 Spud.

12/17 15" @ 137'
Drlg. 575'

12/30 13" @ 880'
10" @ 1735'
Lansing 1845'
Drlg. 1975'

1948
1/7 Drlg. 2515'

1/14 SD

1/21 Miss. 2424'
Viola 2595'
TD 2600'
Abd.

ABANDONED

KAN-10


Marion

Section 23 Township 22 Range 4E

Well No. #1 Jensen "B"

Company E. Adair

Wildcat

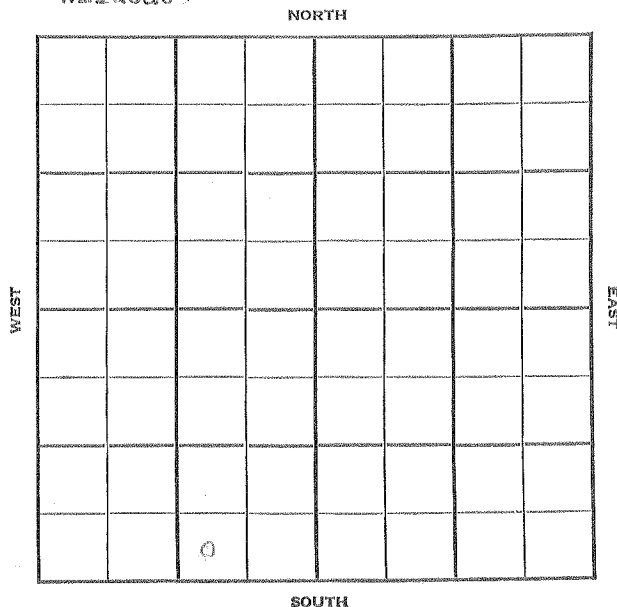


Wildcat

Map No. _____ Sec. 23 Twp. 22 R. 4EWell No. 1 Jensen "B"E. Adair CompanyFIRST REPORT

Contractor

SW SE SW

SECTION PLAT

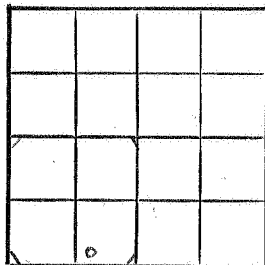

_____ Ft. from N. Line

330 _____ Ft. from S. Line990 _____ Ft. from E. Line

_____ Ft. from W. Line

Marion County

Location X

Rig up _____

Drilling and Remarks:

RECORD

Cased _____ in., _____ ft.

Sand _____

Gas _____

Oil _____

Total Depth _____

PRODUCTION

1st 24 hrs. Nat. _____

1st 24 hrs. after shot _____

Gas _____ Cu. Ft.

Dry Hole _____

Abandoned _____

Date

DEC 3 1947

19

S. J. LEWIS

Scout


Wildcat

Map No. 23 Sec. 23 Twp. 22 R. 4EWell No. 1 Jensen "B"E. Adair CompanyABANDONED

Contractor

SW SE SW

SECTION PLAT

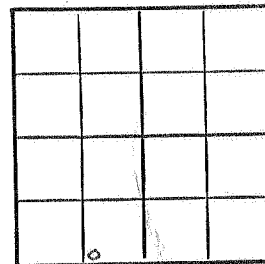

_____ Ft. from N. Line

330 _____ Ft. from S. Line990 _____ Ft. from E. Line

_____ Ft. from W. Line

Marion County

Location _____

Rig up _____

Drilling and Remarks:

*Min's 2424
Videx 2595*

RECORD

Cased _____ in., _____ ft.

Sand _____

Gas _____

Oil _____

Total Depth 2600

PRODUCTION

1st 24 hrs. Nat. _____

1st 24 hrs. after shot _____

Gas _____ Cu. Ft.

Dry Hole _____

Abandoned _____

Date

JAN 21 1948

19

S. J. LEWIS

Scout