


23-22-4E ✓

WELL LOG BUREAU--KANSAS GEOLOGICAL SOCIETY
508 East Murdock, Wichita, Kansas

Company- VENUS OIL
Farm- Jensen No. 1

SEC. 23 T. 22 R. 4E
NW NW SW

Total Depth. 2592'
Comm. 12-3-65 Comp. 12-8-65
Shot or Treated.
Contractor. Blackstone Drlg.
Issued. 5-21-66

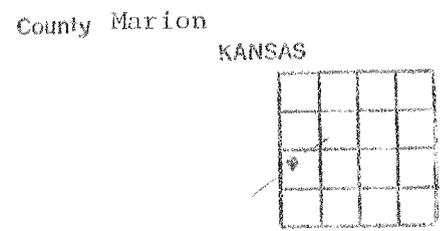

Elevation. 1456 1/2' KB

Production. Dry

CASING:

8 5/8" 214' cem w/ 150 sx

Figures Indicate Bottom of Formations.

lime	570
lime & shale	1325
lime	1600
lime & shale	1800
shale	1853
lime-Kansas City	1950
lime	2230
shale & lime	2440
Mississippi	2464
Kinderhook	2484
Hunton	2592
Total Depth	

TOPS: LOG	
Brown lime	1762
Lansing	1853
Base Kansas City	2223
Fort Scott	2270
Mississippi	2407
Kinderhook	2464
Hunton	2584