


Map No. Kansas Sec. 4 Twp. 22 R. 4

Well No. 9 Tolliffe Farm

Watchorn "O" & G Company

NORTH

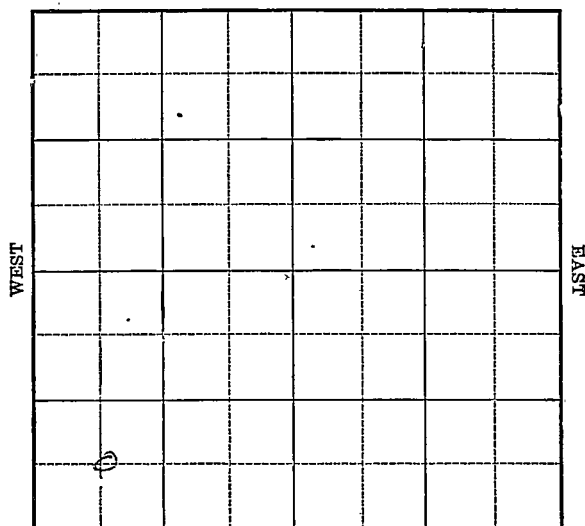

SOUTH

Location

Drilling Remarks

Rig Up

Drilling Remarks

RECORD

Cased_____in. _____ft.

Sand

Gas

Oil

Total Depth_____

PRODUCTION

1st 24 hrs. Nat. _____

1st. 24 hrs. after shot_____

Gas_____cu. ft.

Dry Hole_____


Abandoned

Map No. Kansas Sec. 4 Twp. 22 R. 4Well No. 9 Tolliffe Farm
Watchorn O. & G. Company

Ft. from N. Line

660 Ft. from S. Line

Ft. from E. Line

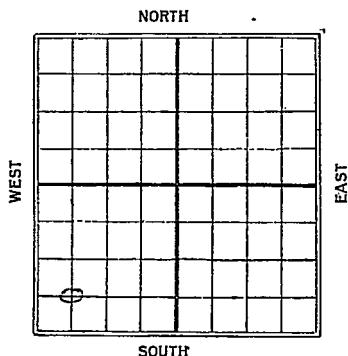660 Ft. from W. Line

C

Date REPORT

1925

5/21 Rigging up

5/29 Spudding

6/5

6/12 for 1060

6/19 S.D. 1060

6/26

7/3

7/10

7/17

7/24 1320

7/31 2220'

8/5 S.D. 2350'

8/14 sand 2450 - 57 T.P.

50 bbls oil

50 " water

23 KANSAS
 Map No. _____ Sec. 4 Twp. 22 R. 4
 Well No. 9 Go. l. l. d. p.
 Watchman oil & gas Co. Company

Contractor _____

COMPLETED

SECTION PLAT

6			

_____ Ft. from N. Line

660 _____ Ft. from S. Line

_____ Ft. from E. Line

660 _____ Ft. from W. Line

Location _____

Rig up _____

Drilling and Remarks:

50 bhs o.s.

50 bhs Watchman

RECORD

Cased _____ in., _____ ft.

Sand 2450-57'

Gas _____

Oil _____

Total Depth 2457'

PRODUCTION

1st 24 hrs. Nat. _____

1st 24 hrs. after shot _____

Gas _____ Cu. Ft.

Dry Hole _____

Abandoned _____

Date

AUG 14 1925

CHAS. L. SHERWOOD

192

Scout

Map No. 23 15400 Sec. 4 Twp. 22 R. 4

Well No. 9 Gollidge
Watchorn and Sons Co Company

Contractor

FIRST REPORTS

_____ Ft. from N. Line

660 Ft. from S. Line

_____ Ft. from E. Line

660 Ft. from W. Line

SECTION PLAT

0			

Location _____

Rig up _____

Drilling and Remarks:

Rigging up.

RECORD

Cased _____ in., _____ ft.

Sand _____

Gas _____

Oil _____

Total Depth _____

PRODUCTION

1st 24 hrs. Nat. _____

1st 24 hrs. after shot _____

Gas _____ Cu. Ft.

Dry Hole _____

Abandoned _____

Date

MAY 21 1925

192

CHAS. L. SHERWOOD

Scout