

Company Bernine-Goering

WEST

EAST

SOUTE

16

Marion KANSAS

Sec. 5 Twp. 22 R. 4E

Well No. #2 Lathrop-Hawk Farm

Bernine-Goering Company

Mendenhall Contractor


 Ft. from N. Line

330' Ft. from S. Line

660' Ft. from E. Line

 Ft. from W. Line

C S/2 SE SE

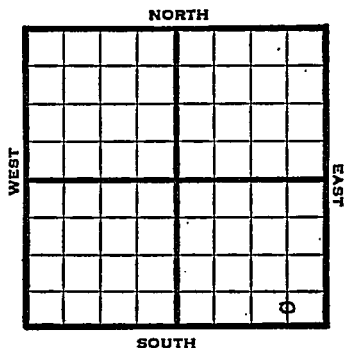

1950 Elev. 1428' REPORT

5/17 Location
6/7 8-5/8" @ 130'
Viola 2462'
5 1/2" @ 2462'
TD 2464'
25 BOPD, 50% wtr
ED 2464'

COMPLETED

Map No. _____ Sec. 5 Twp. 22 R. 4E

Well No. 2 Lathrop-Hawk

Bernine-Goering _____ Company

Mendenhall Contractor

C S/2 SE SE


SECTION PLAT

_____ Ft. from N. Line

330 Ft. from S. Line

660 Ft. from E. Line

_____ Ft. from W. Line

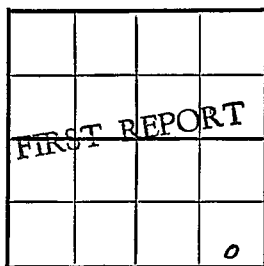

Marion

Location X

Rig up _____

Drilling and Remarks:

RECORD

Cased _____ in., _____ ft.

Sand _____

Gas _____

Oil_____

Total Depth_____

PRODUCTION

1st 24 hrs. Nat. _____

1st 24 hrs. after shot_____

Gas_____ Cu. Ft.

Dry Hole_____

Abandoned_____

Date _____

MAY 17 1950

J. E. TYRA Scout

19

Kans28

Map No. _____ Sec. 5 \ Twp. 22 R. 4E

Well No. 2 Lathrop-Hawk

Bernine-Goering Company

C S/2 SE SE Contractor

E1.1428


SECTION PLAT

_____ Ft. from N. Line

330 _____ Ft. from S. Line

660 _____ Ft. from E. Line

_____ Ft. from W. Line

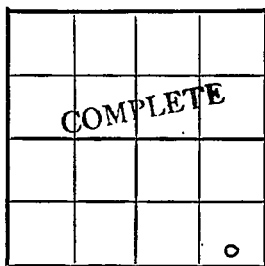

Marion

Location _____

Rig up _____

Drilling and Remarks:

8 5/8' @ 130.

Viola 2462

5 1/2 @ 2462

T.D. 2464

25 BOPD

50% wtr.

RECORD

Cased _____ in. _____ ft.

Sand _____

Gas _____

Oil _____

Total Depth 2464

PRODUCTION

1st 24 hrs. Nat. _____

1st 24 hrs. after shot _____

Gas _____ Cu. Ft.

Dry Hole _____

Abandoned _____

Date

JUN 7 1950 19

J. E. TYRA Scout