
Form 51—5M—9-28—27423

Map No. KANSAS Sec. 5 Twp. 22 S R. 4 E

Well No. 31 - Townsend Farm

Watchorn O & G. Company

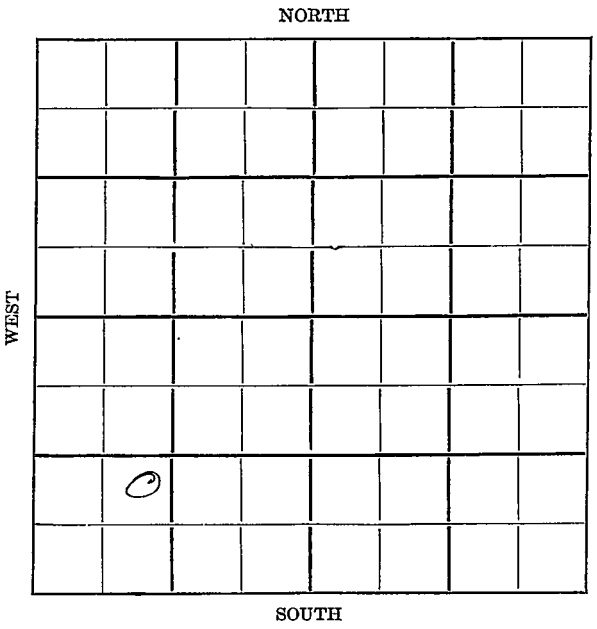

13

Location

Drilling Remarks

Rig Up

Drilling Remarks

RECORD

Cased ..... in. ..... ft.

Sand .....

Gas .....

Oil .....

Total Depth .....

PRODUCTION

1st 24 hrs. Nat. .....

1st 24 hrs. after shot .....

Gas ..... cu. ft. .....

Dry Hole .....

Abandoned .....

Form 252A—5M—5-28—Mid-West

Map No.....Sec.....Twp.....R.....

Well No.....Farm


.....Company

.....Ft. from N. Line

.....Ft. from S. Line

.....Ft. from E. Line

.....Ft. from W. Line

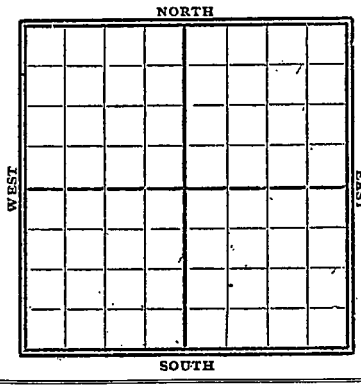

1923

Date	REPORT
	Gypsy Record
6/21	Rod TD 2650'

FORM 26 250 BKS. 4-28 WESTERN


MAP NO. _____ SEC. 5 TWP. 22S R. 4E

WELL NO. 31 Townsend

Natchez Nat Gas. COMPANY

_____ CONTRACTOR

SECTION PLAT

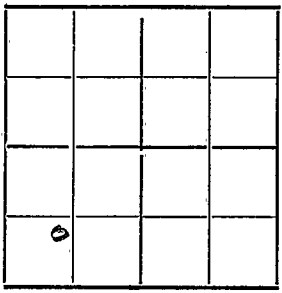

_____ FT. FROM N. LINE

_____ FT. FROM S. LINE

_____ FT. FROM E. LINE

_____ FT. FROM W. LINE

no Record

LOCATION _____

RIG UP _____

DRILLING AND REMARKS:

Abandoned

RECORD

CASED _____ IN. _____ FT.

SAND _____

GAS _____

OIL _____

TOTAL DEPTH No 50

PRODUCTION

1ST 24 HRS. NAT. _____

1ST 24 HRS. AFTER SHOT _____

GAS _____ CU. FT.

DRY HOLE ✓

ABANDONED _____

DATE 6-21 1923

_____ SCOUT