
Marion KANSAS

SECTION 5 TOWNSHIP 22S RANGE 3E

WELL NO. #1 Obermeyer

COMPANY Adair Oil

NORTH SW SW SW

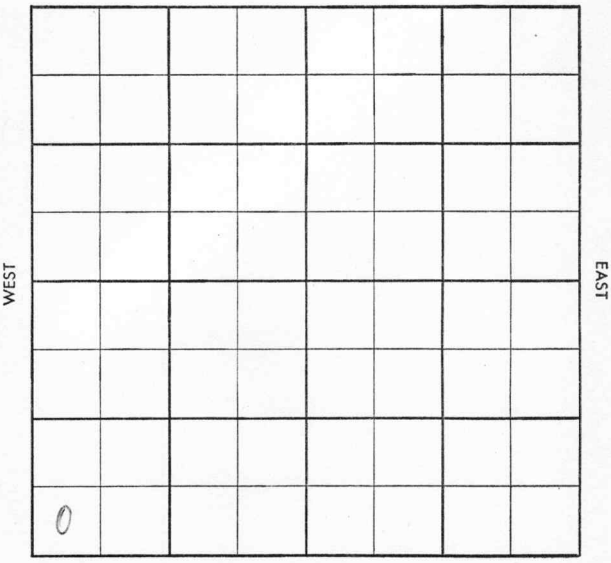

FORM 504-3 SUNRAY

Twp. X Pool X

Co. X Facet 10

S-513-B

County Marion Elev.

Sec. 5 Twp. 22 Rge. 3E

Company Adair Oil

Farm Name Obermeyer No. 1

TOPS	DEPTH	LOG	DATUM
Anh.			
Tp.			
H.			
Tr.			
Dg.			
B. L.			
L.			
K.C.			
B.K.C.			
Ce.			
C.			
M.			
M.			
K.			
Mz.			
Mq.			
V.			
S.			
S.			
A.			
R.			
Pf.			
G.			
T.D.			

Loc. in Sec. SW SW SW

Geol.

Contr. Raymond

Pool Peabody



Date Comm.

Cellar & pits

Co. Lse. No. Sec. T. R.

Twp. Pool

Co. Feed

S-513-B

Co.

County Marion Elev 1410 DF 1413 KB

Sec. 5 Twp. 22 Rge. 3E

Company Adair Oil

Farm Name Obermeyer No. 1

TOPS	DEPTH	LOG	DATUM
Anh.			
Tp.			
H.			
Tr.			
Dg.			
B.L.			
L.	2002		
K.C.			
B.K.C.	2385		
Ce.			
C.	2580		
M. Chert	2594		
M. LI	2715		
K.	2763		
Mz. Hunt	2886		
Mq.			
V.			
S.			
S.			
A.			
R.			
Pf.			
G.			
T.D.	2900		

Loc. in Sec. SW SW SW

Geol.

Contr. Raymond

Lse.

Pool Peabody

ABANDONED

AUG 20 '58

No.

Date Comm. 8-7-58 8" 150

Cellar & pits AUG 13 '58 @ 204 AUG 20 '58

Sec.

T.

D & A

R.