


Map No. **KANSAS** Sec. 5 Twp. 22 ^S R. 4 ^E

Well No. 7-Townsend Farm
Watchorn Company

NORTH

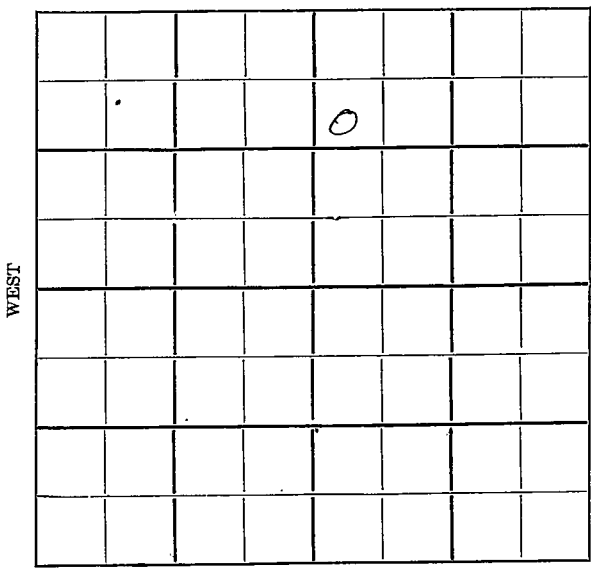

SOUTH

Location.....

Drilling Remarks

.....

.....

Rig Up.....

Drilling Remarks

.....

.....

RECORD

PRODUCTION

Cased..... in..... ft.

Sand.....

Gas.....

Oil.....

Total Depth.....

1st 24 hrs. Nat.....

1st 24 hrs. after shot.....

Gas..... cu. ft.....

Dry Hole.....

Abandoned.....

Map No. Sec. Twp. R.

Well No. Farm


..... Company

..... Ft. from N. Line

..... Ft. from S. Line

..... Ft. from E. Line

..... Ft. from W. Line

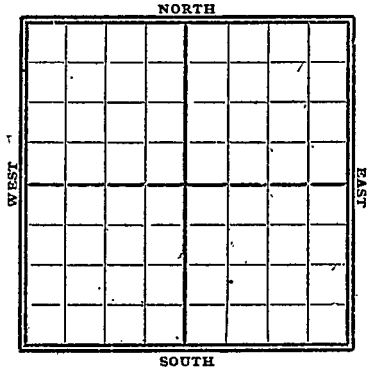

1921

Date

REPORT

Gypsy Records

8/25

Well 'TD 2494'

MAP No. _____ SEC. 5 TWP. 27S R. 1E

WELL No. J. Townsend
Hatchson COMPANY

CONTRACTOR _____

SECTION PLAT

		0	

_____ FT. FROM N. LINE

_____ FT. FROM S. LINE

_____ FT. FROM E. LINE

_____ FT. FROM W. LINE

LOCATION _____

RIG UP _____

DRILLING AND REMARKS:

see above

1
1
1

RECORD

CASED _____ IN. _____ FT.

SAND _____

GAS _____

OIL _____

TOTAL DEPTH 2494

PRODUCTION

1ST 24 HRS. NAT. _____

1ST 24 HRS. AFTER SHOT _____

GAS _____ CU. FT.

DRY HOLE

ABANDONED

DATE

8/25 1921

SCOUT