
Form 51 5M 11-23 13896

Map No. Kan Sec. 5 Twp. 22 R. 4

Well No. 41 Davonsend Farm

Watchorn O&G. Company

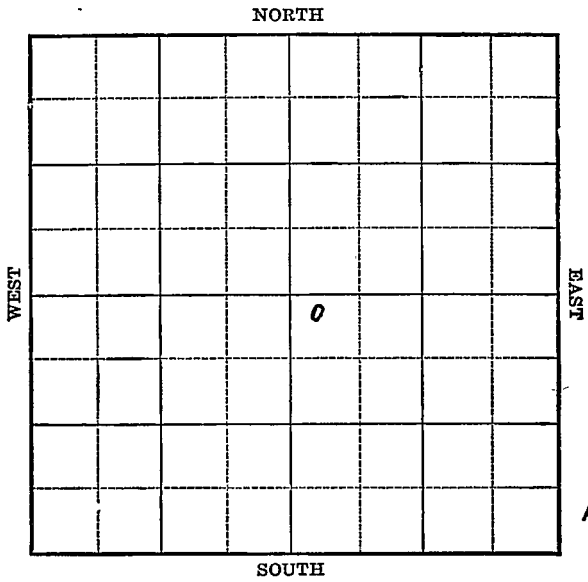

10

Location _____

Drilling Remarks:

Rig Up _____

Drilling Remarks:

RECORD

Cased _____ in. _____ ft.

Sand _____

Gas _____

Oil _____

Total Depth _____

PRODUCTION

1st 24 hrs. Nat. _____

1st 24 hrs. after shot _____

Gas _____ cu. ft.

Dry Hole _____

Abandoned _____

Form 252A 5M 8-24 16529

Map No. Kan Sec. 5 Twp. 22 R 4

Well No. 41 Townsend Farm


Hatchhorn Oil Co. Company

220 Ft. from N. Line

_____ Ft. from S. Line

_____ Ft. from E. Line

440 Ft. from W. Line

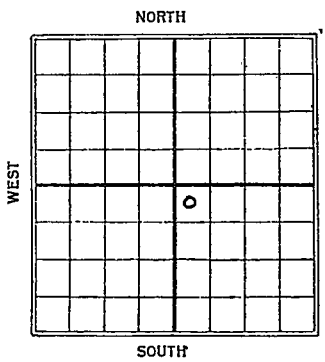

C

Date 1925	REPORT
7/10	Bldgrs
7/17	Spud
7/24	350'
7/31	— —
8/7	———
8/14	600'
8/19	800'
8/26	1720'
9/3	2240'
9/11	Sand 2344–2346 120 Bbls Oil + Lots of Water

Form 26—1M Bks.—3-23—11959.

Map No. 23 Kinds Sec. 5 Twp. 22 R. 4

Well No. 41 Town Land

Watchorn Oil Co Company

Contractor

FIRST REPORTS


220 Ft. from N. Line

Ft. from S. Line

Ft. from E. Line

440 Ft. from W. Line

SECTION PLAT

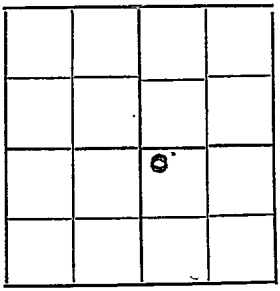

Location

Rig up Bldg

Drilling and Remarks:

RECORD

Cased in., ft.

Sand

Gas

Oil

Total Depth

PRODUCTION

1st 24 hrs. Nat.

1st 24 hrs. after shot

Gas Cu. Ft.

Dry Hole

Abandoned

Date

JUL 10 1925

192

CHAS. L. SHERWOOD

Scout

Form 26—1M Bks.—3-23—11959. Marion Co

28

Map No. KANSAS Sec. 5 Twp. 22 R. 4

Well No. 41 Town Land

Watchorn Oil & Gas Co Company

Contractor

COMPLETED


990 Ft. from N. Line

Ft. from S. Line

Ft. from E. Line

990 Ft. from W. Line

SECTION PLAT

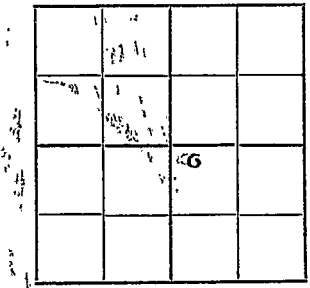

Location

Rig up

Drilling and Remarks:

120 bbls oil.

Lots of water.

RECORD

Cased in., ft.

Sand 3314 - 3346

Gas

Oil

Total Depth 3346

PRODUCTION

1st 24 hrs. Nat.

1st 24 hrs. after shot

Gas Cu. Ft.

Dry Hole

Abandoned

Date

SEP 11 1925

192

CHAS. L. SHERWOOD

Scout